


T.32S., R.5W., W.M.

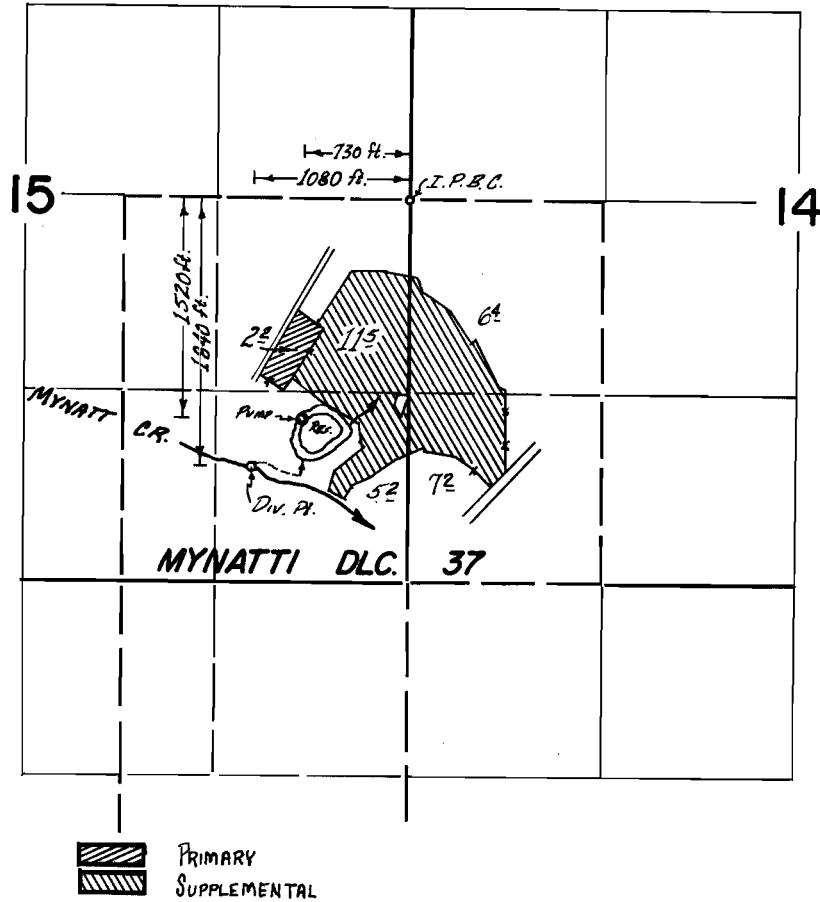

**FINAL PROOF SURVEY**  
UNDER

R-47413                      R-5714  
Application No. 47912    Permit No. 35605  
IN NAME OF  
LOUIS BRADY

Surveyed 23 Aug. 1972, by L.E. GOULD