


G-2793
39147

T13S., R.31E., W.M.

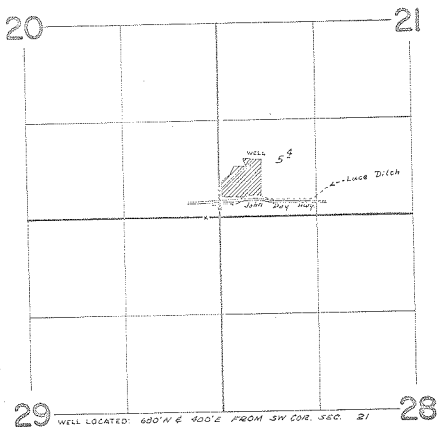

FINAL PROOF SURVEY UNDER

Application No. G-2997 Permit No. G-2793
IN NAME OF

BARNEY A. & MARY L. PEREIRA

Surveyed July 12 1972, by D. Norby