




300

WATER RIGHT APPLICATION MAP

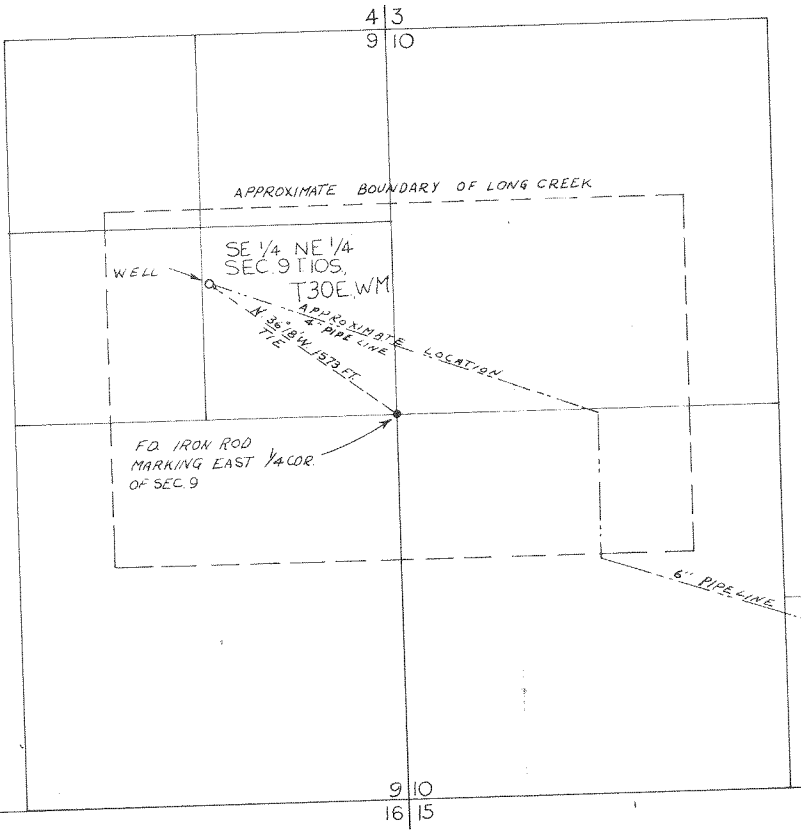


APPLICATION MAP

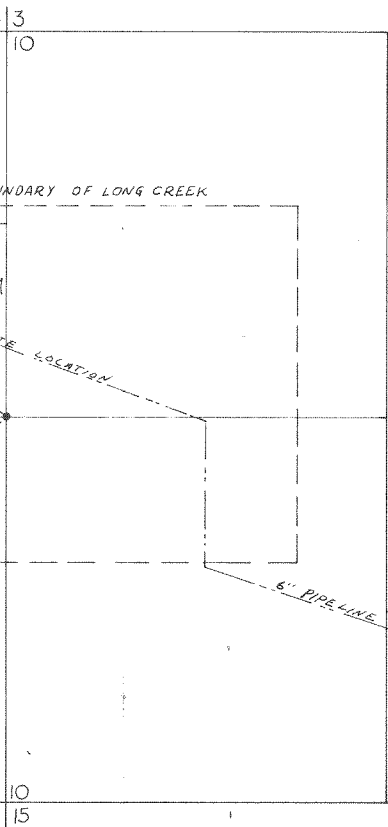

PREPARED FOR:
TOWN OF LONG CREEK

SCALE: 8" = 1 MILE

RESERVOIRS
SW 1/4 SE 1/4
SEC. 10