


T13S., R. 30E., W.M.

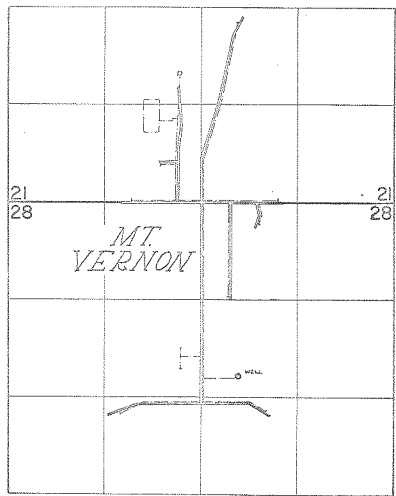

WELL LOCATED: 2550' S & 520' E FROM N 1/4 COR. SEC. 28

FINAL PROOF SURVEY
UNDER

Application No. G-4961, Permit No. G-4681
IN NAME OF

CITY OF MT. VERNON

Surveyed July 18, 1972, by D. Narby