


# T.6&7S. R.31E. W.M.

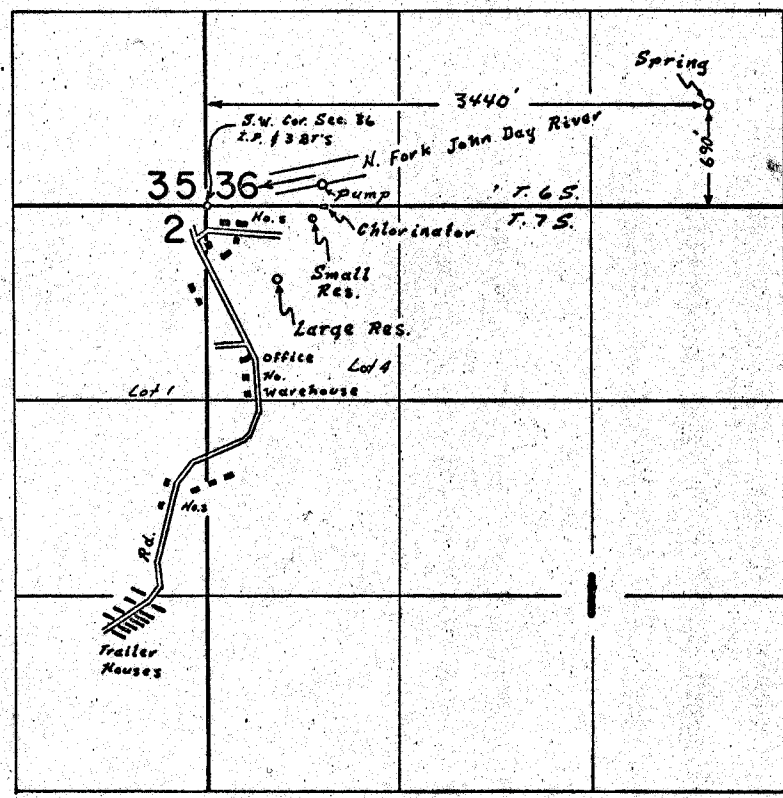

## FINAL PROOF SURVEY UNDER

Application No. 33085 Permit No. 26190  
 IN NAME OF  
*U.S. Forest Service Dept. of Agriculture*

Surveyed 2 Aug. 1972, by L.E. Gould