


T.13S., R.29E., W.M.

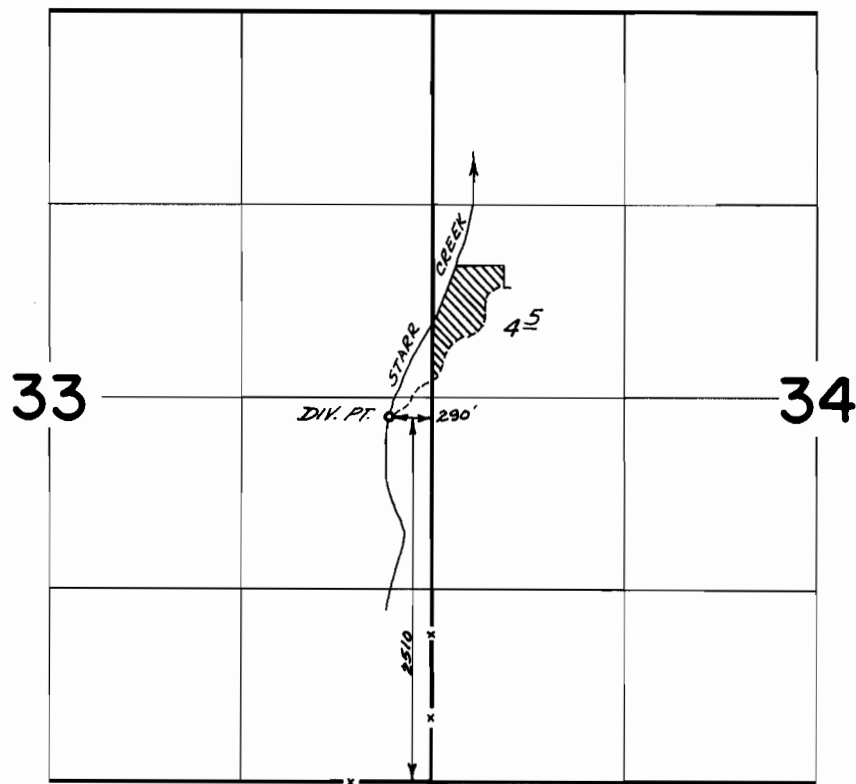

FINAL PROOF SURVEY
UNDER

Application No. 37567 Permit No. 28037
IN NAME OF

JAMES L. WORTH

Surveyed July 19 1972, by D. Norby