


T.12S., R.26E., W.M.

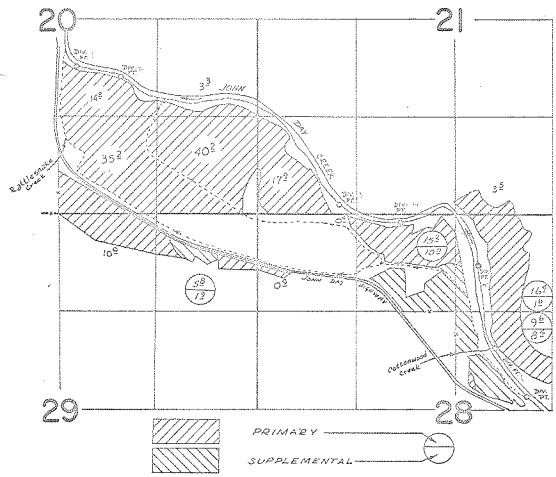

DIV. PT. LOCATED:
 1. 2000' N & 280' E
 2. 1860' N & 880' E
 3. 130' N & 3850' E
 4. 110' S & 4700' E
 5. 690' S & 5750' E
 6. 1820' S & 3970' E
 7. 2470' S & 6400' E
 ALL FROM 5 1/4 COR
 SEC. 20.

FINAL PROOF SURVEY UNDER

Application No. 38427, Permit No. 28617
IN NAME OF

MR. and MRS. L.E. MASCALL

Surveyed Aug. 1 1972, by D. Norby