


P30323

39753

T.13S., R.33 & 34E., W.M.

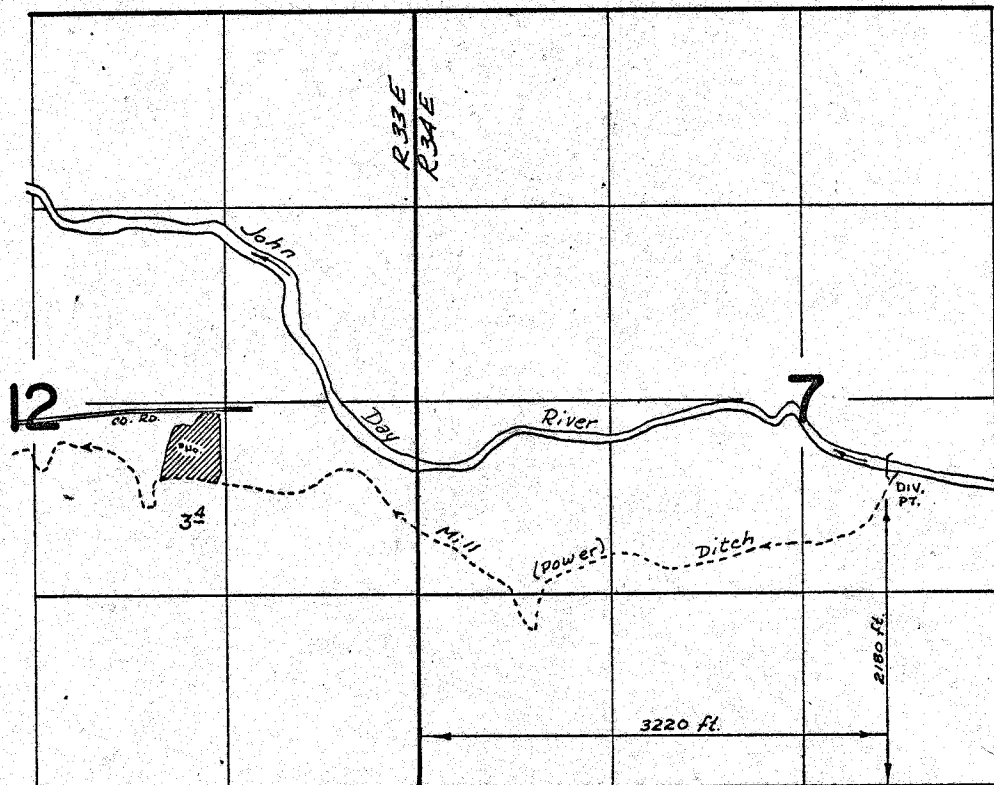

FINAL PROOF SURVEY UNDER

Application No. 40707 Permit No. 30323
IN NAME OF

R. J. STANBRO

Surveyed Aug. 3 1972, by D. Narby