


P 30487

39754

T.13S., R.29E., W.M.

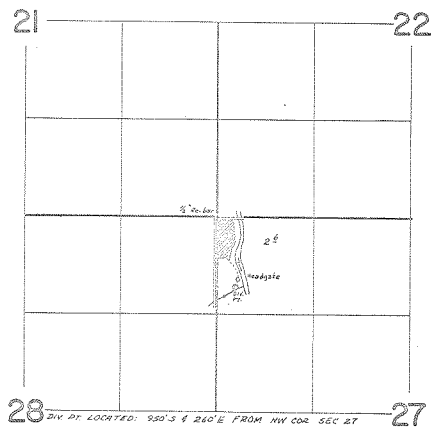

FINAL PROOF SURVEY UNDER

Application No. 40900 Permit No. 30484
IN NAME OF

DONALD M. RIPA

Surveyed July 19 1972 by D. Norby