


P 32766  
39756

# T.13S., R.31E., W.M.

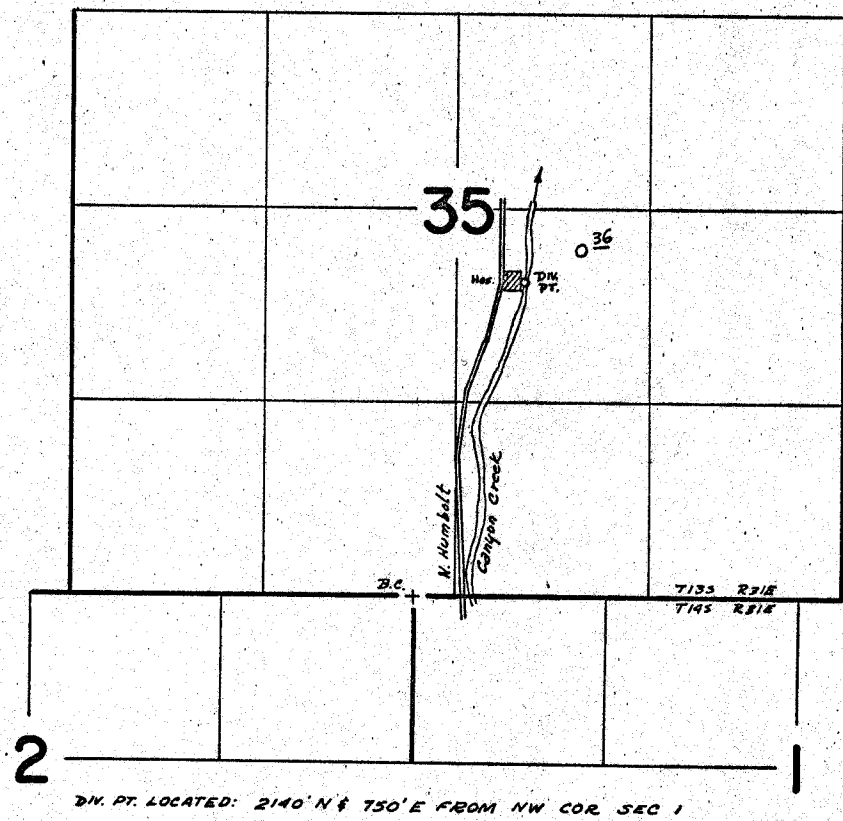

## FINAL PROOF SURVEY UNDER

Application No. 43830 Permit No. 32766  
IN NAME OF

LLOYD E. CUMMINGS

Surveyed July 13, 1972, by D. Narby