


# T.13S., R.31E., W.M.

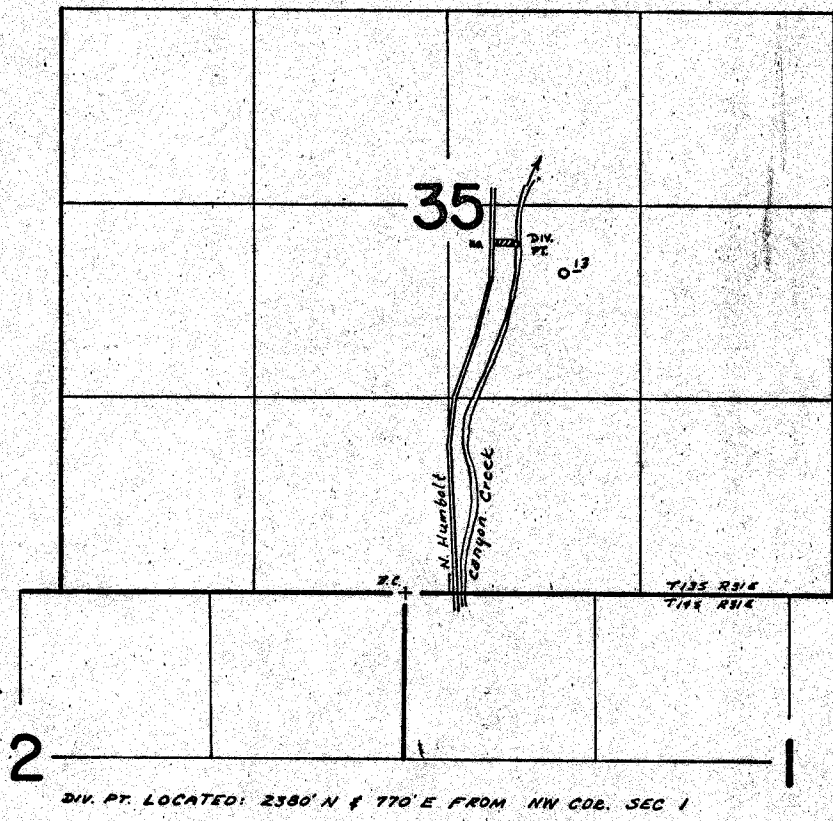

## FINAL PROOF SURVEY UNDER

Application No. 43883 Permit No. 32790  
 IN NAME OF  
FRED LANG

Surveyed July 13, 1972, by D. Norby