


33929

7975

T. 11 S. R. 35 E. W. M.

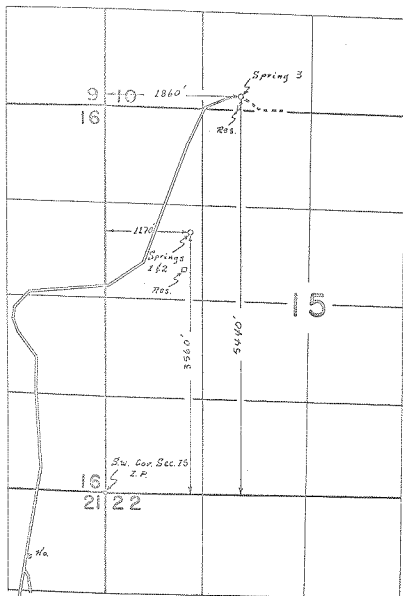

FINAL PROOF SURVEY
UNDER

Application No. 45468 Permit No. 33929
IN NAME OF
Henry Ricco

Surveyed 8 Aug. 1972, by L.E. Gould