


35722
C-39759

T.11S. R.29E. W.M.

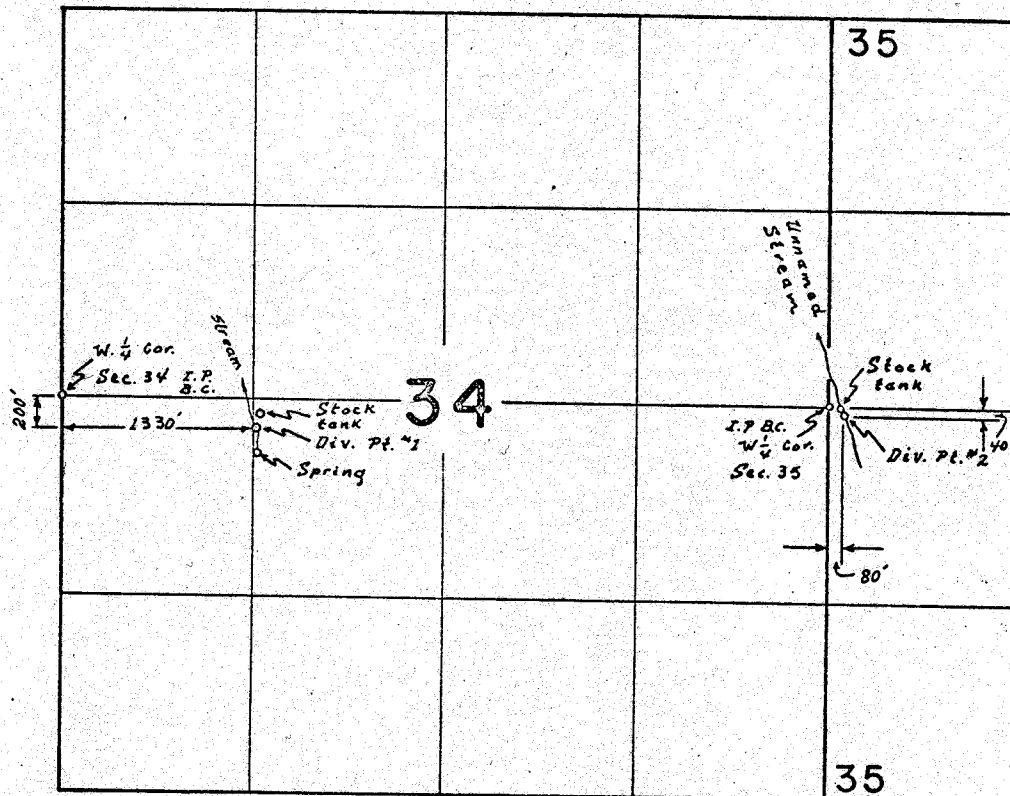

FINAL PROOF SURVEY
UNDER

Application No. 48824 Permit No. 35722
IN NAME OF
William A. & Blanche E. Patterson

Surveyed 9 Aug. 1972, by L. E. Gould