


# T. 23 S. R. 31 E. W. M

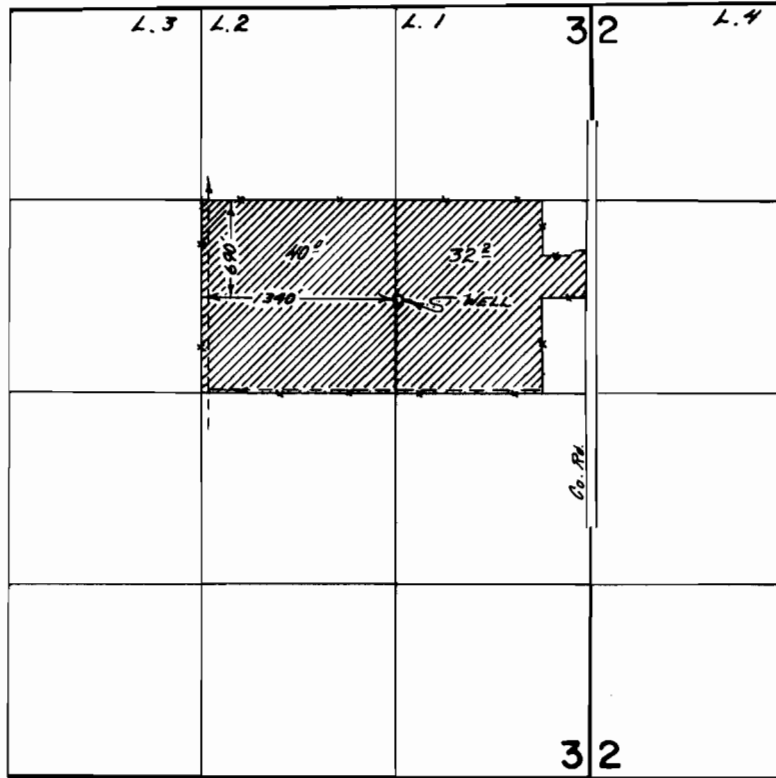

## FINAL PROOF SURVEY UNDER

Application No. C-4420 Permit No. G-4165  
IN NAME OF

TOMMY JOSEPH SWISHER

Surveyed Aug. 24 1972, by P. G. MURPHY