


T. 26 S. R. 34 E. W.M.

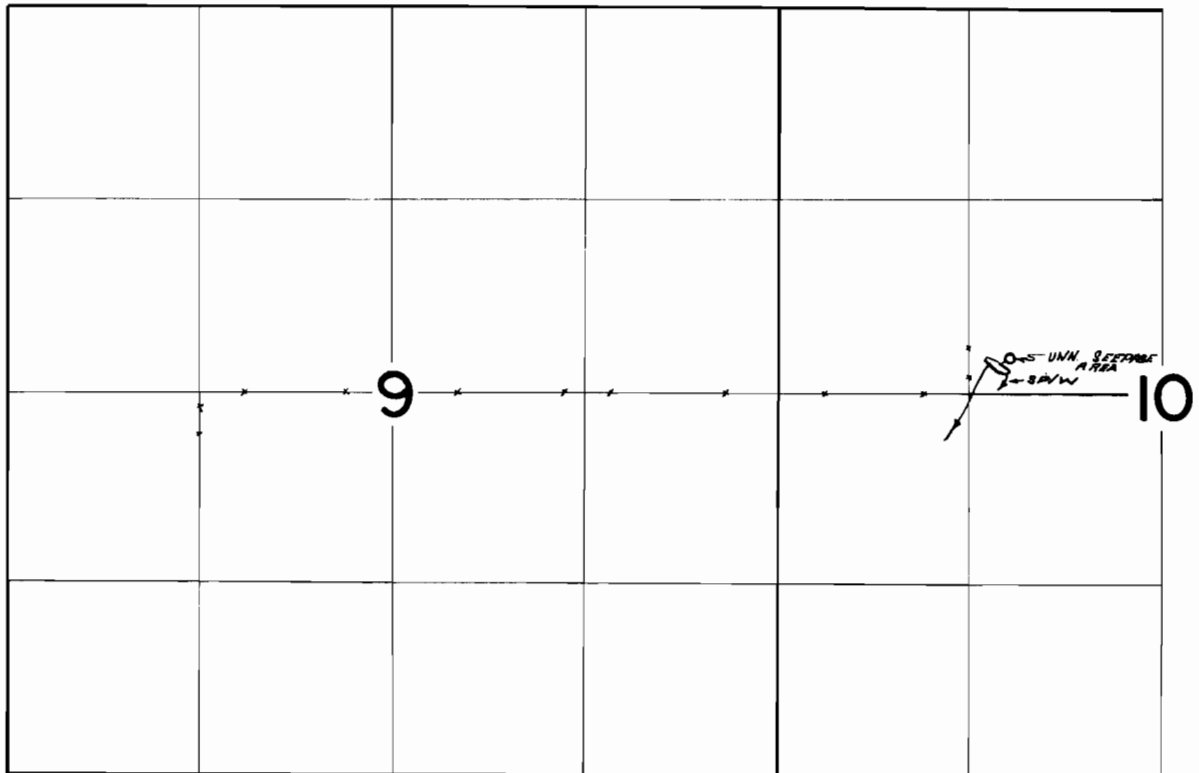

Res. Loc. 200' N F 140' E FROM SW COR SE 1/4 NW 1/4 Sec 10

FINAL PROOF SURVEY
UNDER

Application No. P-30247 Permit No. R-3889
IN NAME OF

NEVIN THOMPSON

Surveyed Nov. 15 1972, by R. G. MUCKEN