


T. 25 S. R. 29 E. W. M

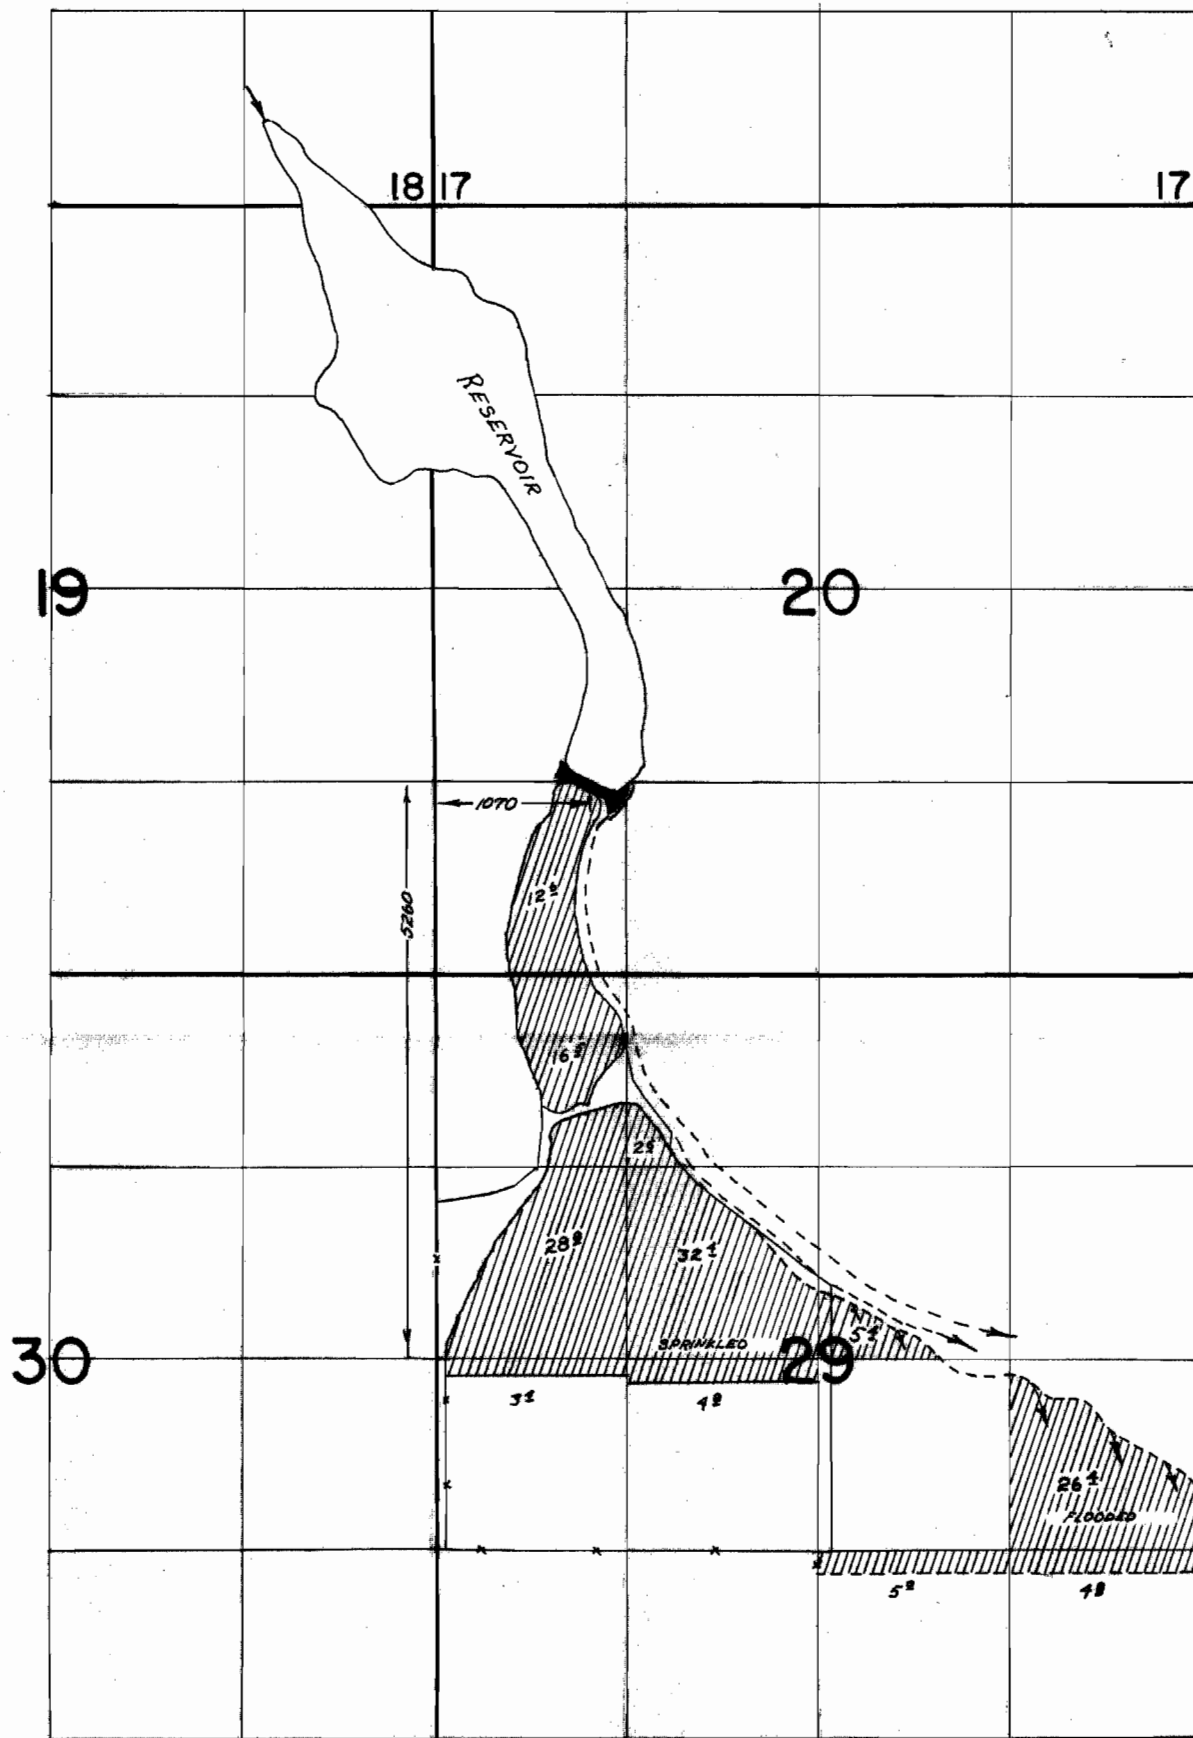

FINAL PROOF SURVEY

UNDER

Application No. ⁴³⁷³⁵ R-43731 Permit No. ³³⁰⁶¹ R-5715

IN NAME OF

A. A. & DONNA R. HURLBURT

Surveyed Aug. 22, 1972, by R. G. Mockel