


T. 36S. R. 6W. W.M.

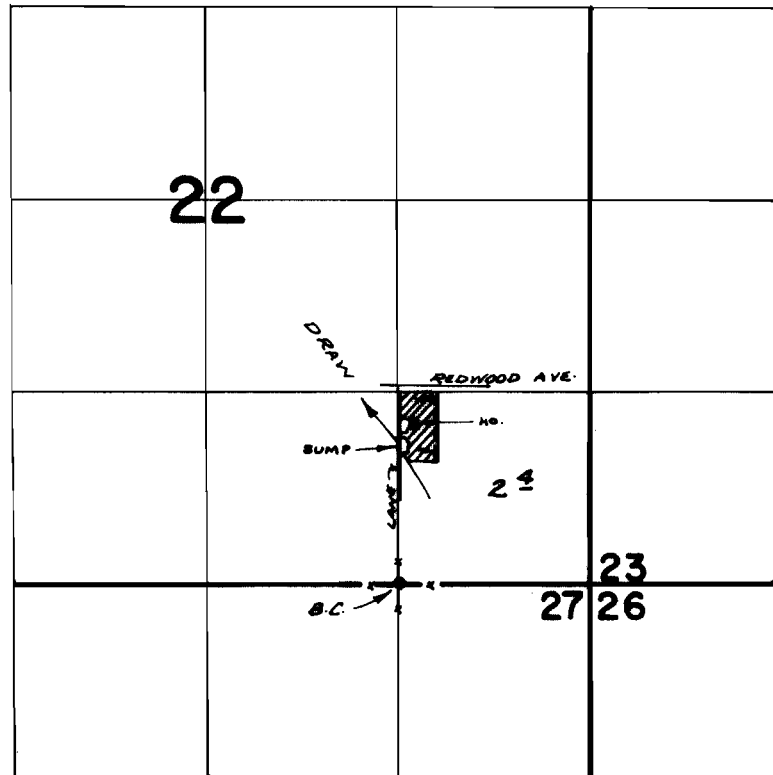

FINAL PROOF SURVEY
UNDER

Application No. G-4370 Permit No. G-4122
IN NAME OF

JOSEPH R. RITSCH

Surveyed APR. 20 1972, by R. MUCKEN