


G-4242

# T. 39 S. R. 8 W.W.M.

Telephone call from Ralph Jackson on April 4, 1974 with information that the supplemental irrigation asked for on this permit covers the same area as that on permit G-225, and the location of the second well is as shown on the abstract for permit G-4242.

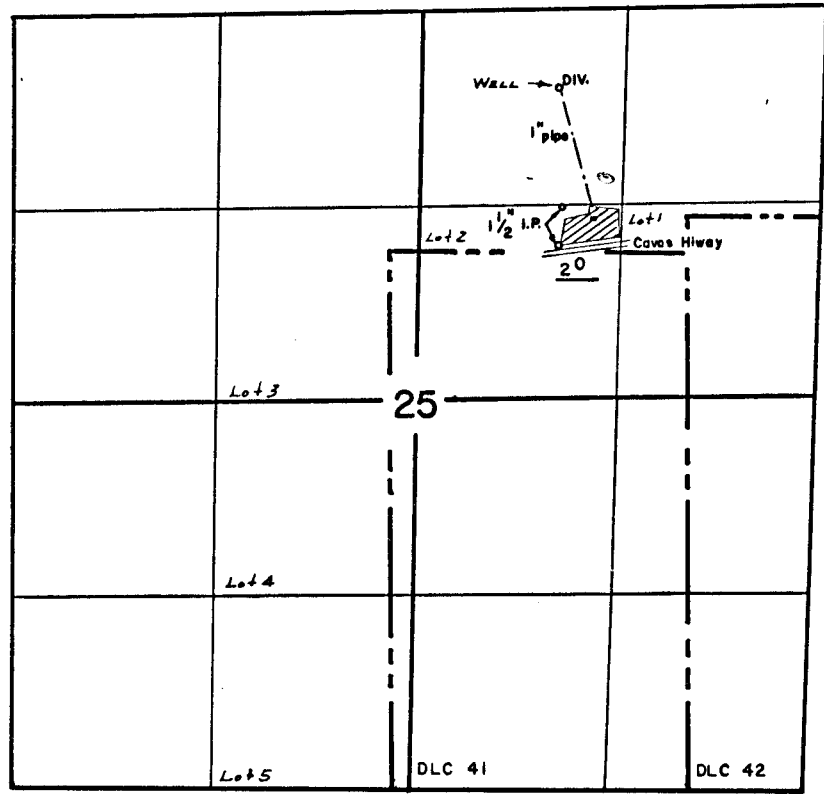

*1/2\"/>*

## FINAL PROOF SURVEY UNDER

Application No. ~~6-2408~~ Permit No. ~~G-2257~~  
IN NAME OF

.....JOHN W. & GLADYS T. ENGLAND.....

Surveyed May 12, 1965, by R. B. STEIMER