T.34S.R.5W.W.M.

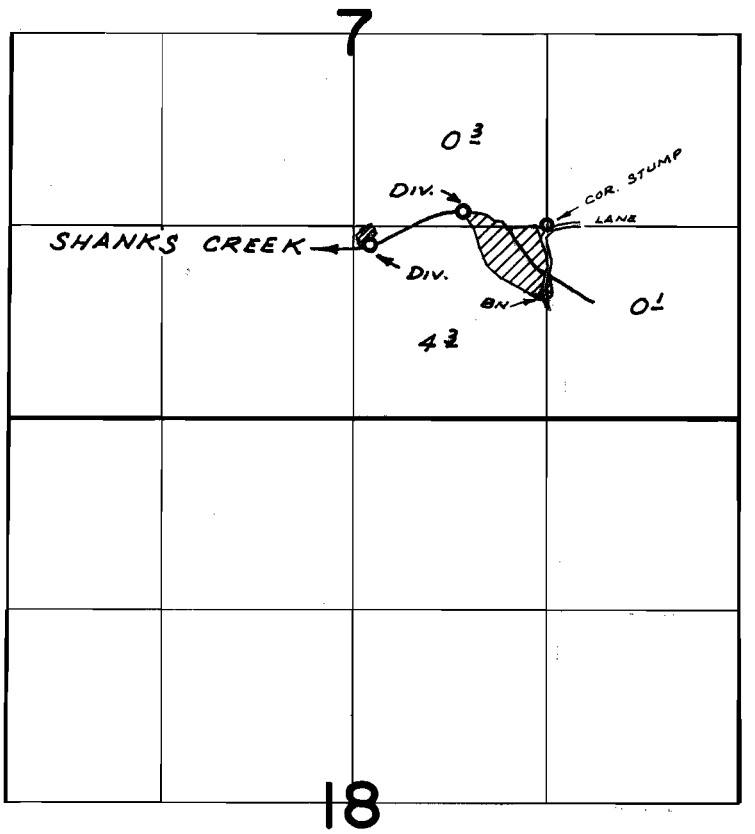

DIV. PTS. LOC: 580' W. & 100' N; 1220' W. & 130' S, BOTH FROM NE. COR. SW¼ SE¼ SEC. 7

FINAL PROOF SURVEY
UNDER

Application No. 41790 Permit No. 31284
IN NAME OF

JOHN E. WHEELER

Surveyed APR. 15, 1972, by R. MUCKEN

1972 - J