


T.40S., R.88&9W., W.M.

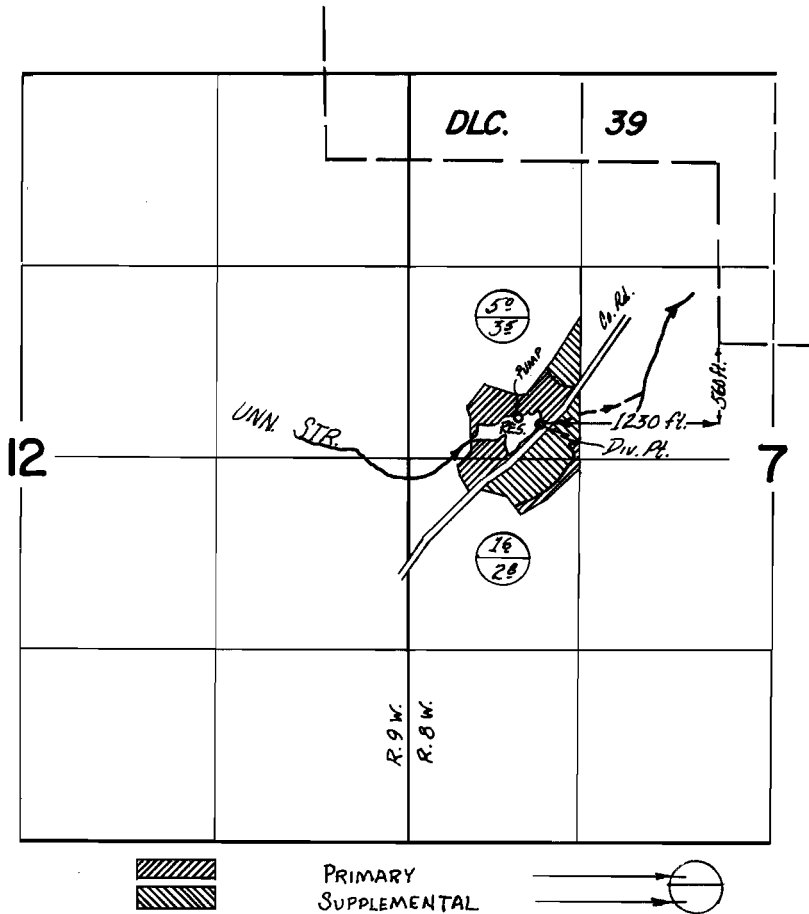

FINAL PROOF SURVEY
UNDER

R-40383 R-4513
Application No. 40384 Permit No. 30106
IN NAME OF

WENDELL M. FALES

Surveyed 31 Oct. 1972, by L.E. GOULD