


T. 5 S. R. 2 W. W.M.

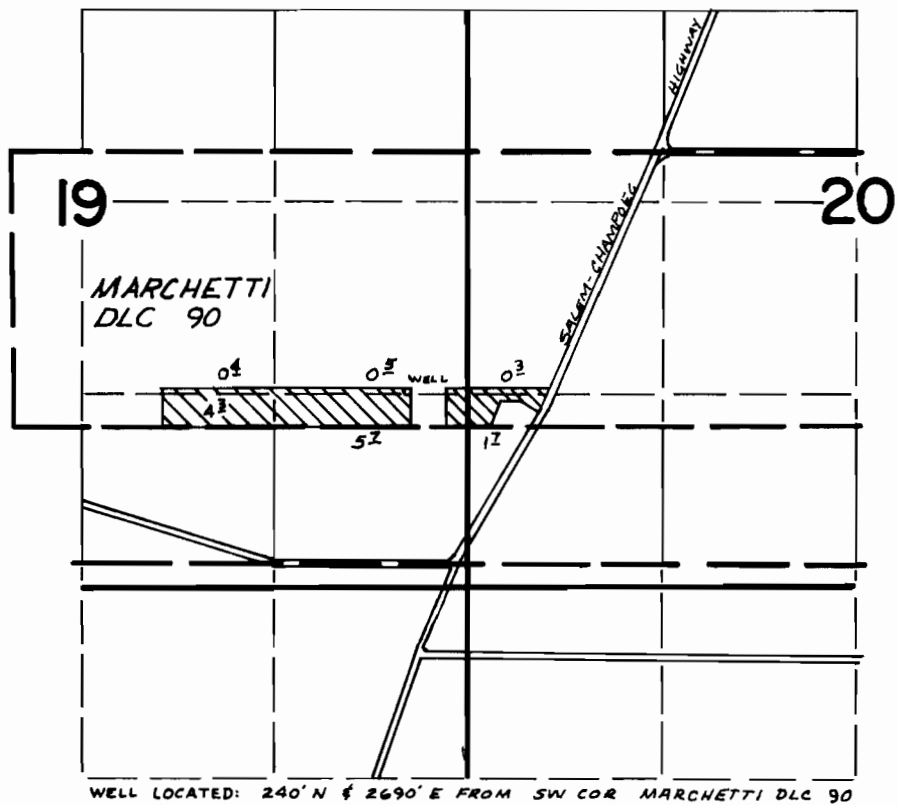

FINAL PROOF SURVEY UNDER

Application No. G-3661 Permit No. G-3437
IN NAME OF

JAMES T. BLACK

Surveyed Sept. 22 1972, by D. Norby