


T.5S. R.2W. W.M.

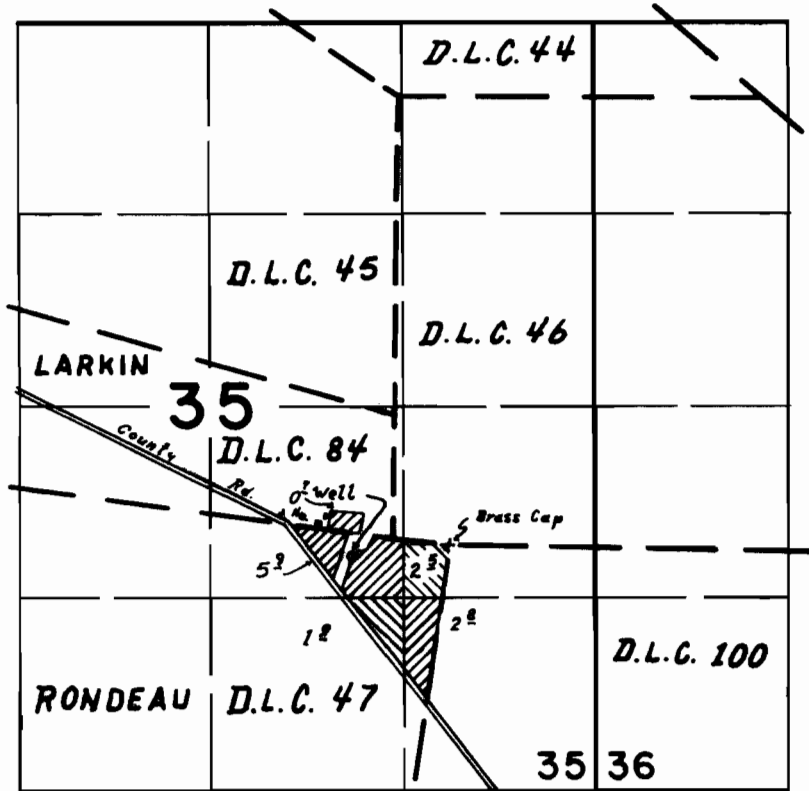

Well loc. 650' W. of 80' S. from N.E. cor. D.L.C. 47

FINAL PROOF SURVEY UNDER

Application No. G-3704 Permit No. G-3504
IN NAME OF

James C. Phillips

Surveyed 11 OCT. 1972, by D. O'Reilly