


T.7S. R.2W. W.M.

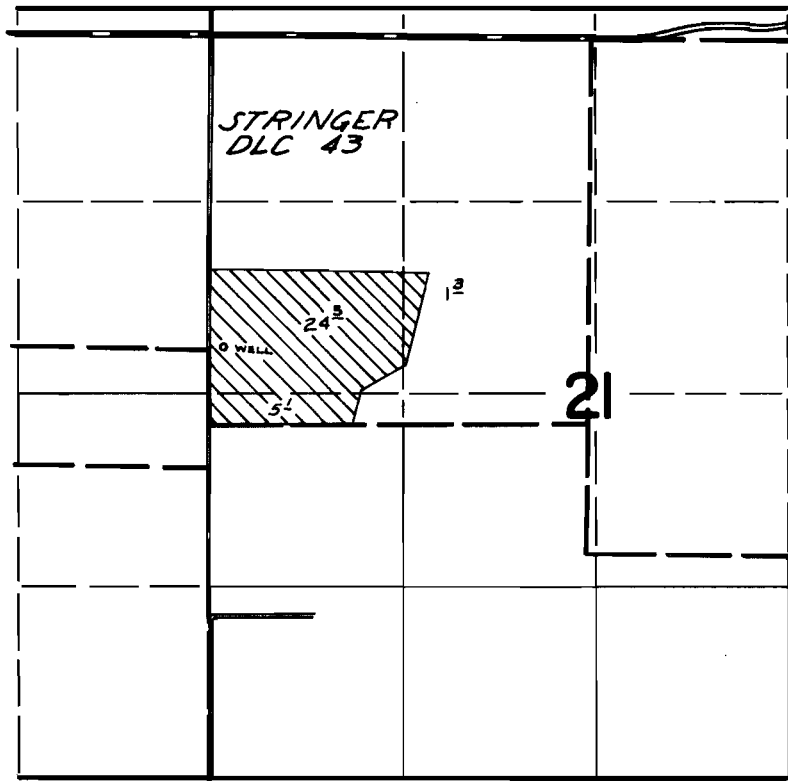

WELL LOCATED: 530' N & 110' E FROM SW COR. STRINGER DLC 43

FINAL PROOF SURVEY
UNDER

Application No. G-3818 Permit No. G-3601
IN NAME OF

DAN STAUFFER

Surveyed July 7 1972, by D. Norby