


T. 5 S. R. 2 W., W. M. .

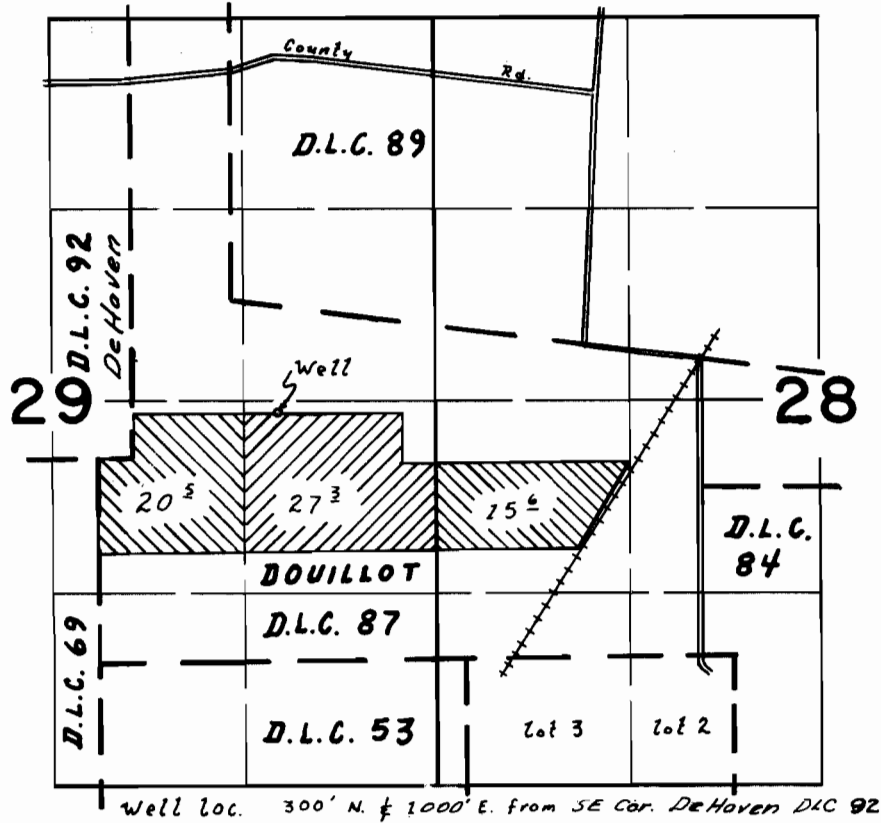

FINAL PROOF SURVEY
UNDER

Application No. G-4099 Permit No. G-3847
IN NAME OF

Alan Haslebacher

Surveyed 10 OCT 1972, by D. O'Reilly