


T. 5 S. R. 2 W. W.M.

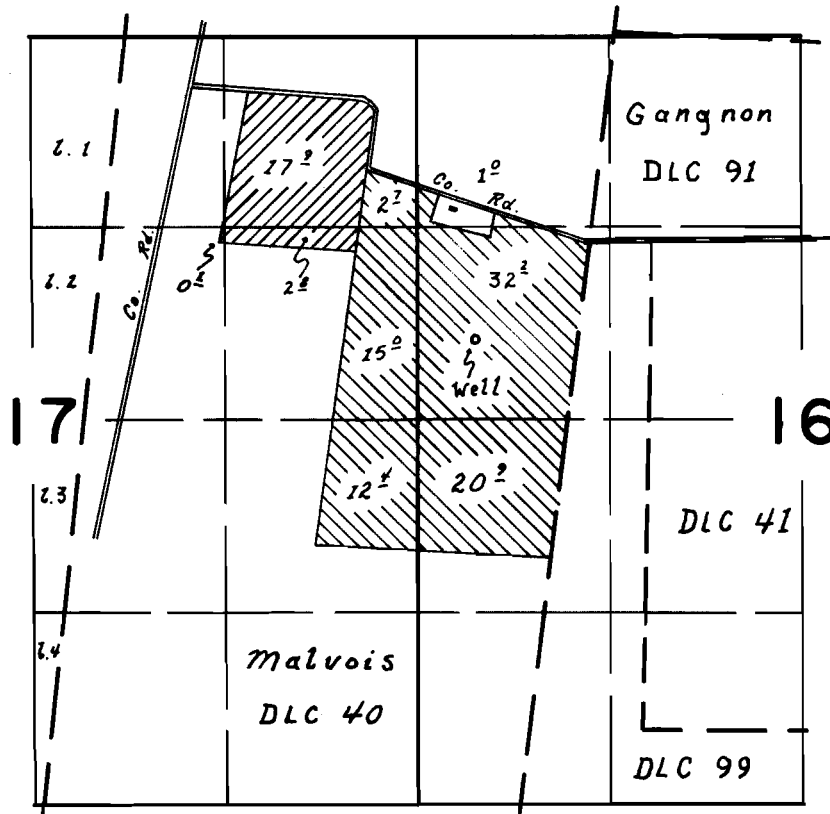

Well loc. 675'S. & 775'W. from S.W. cor. Gangnon DLC 91

 primary
 supplemental

FINAL PROOF SURVEY UNDER

Application No. G-4267... Permit No. G-4019
IN NAME OF

James E. Davidson

Surveyed 9 OCT. 1972, by D. O'Reilly