


# T.5 S., R.2 W., W.M.

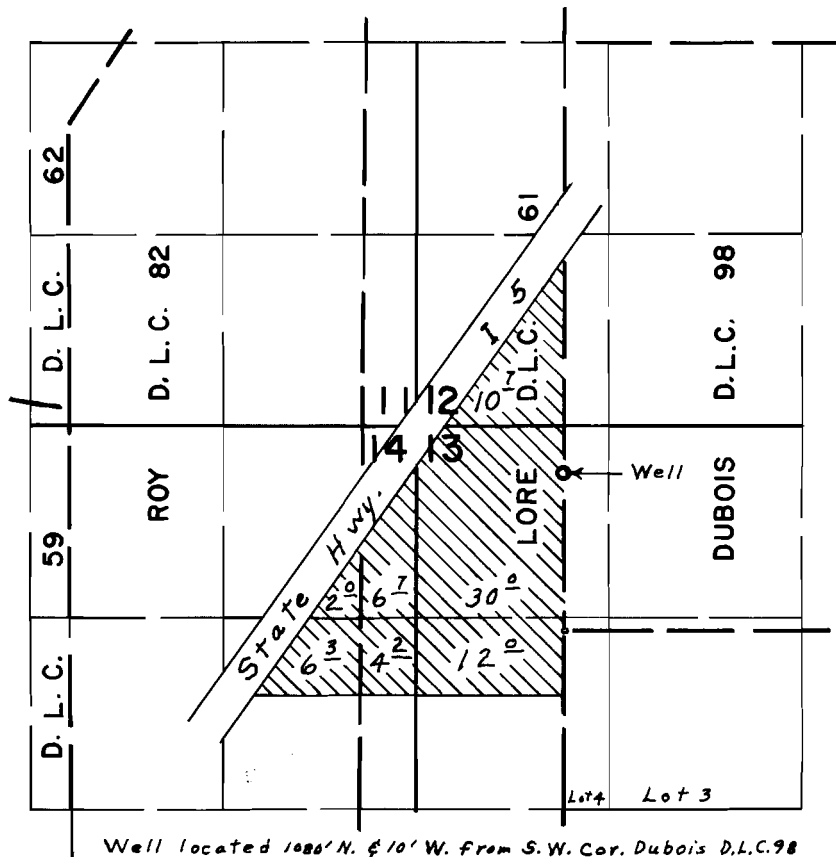

## FINAL PROOF SURVEY UNDER

Application No. G-4286 Permit No. G-4035  
IN NAME OF

PAUL J. WILLARD

Surveyed Sept. 7, 1972, by L. E. Gould