


# T.7S. R.1&2W. W.M.

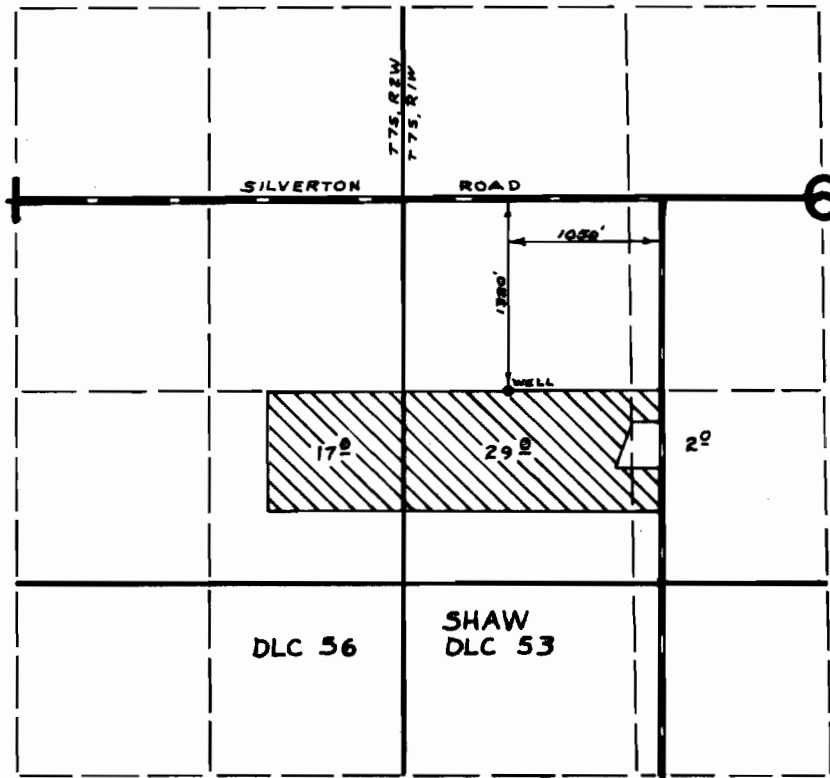

## FINAL PROOF SURVEY UNDER

Application No. G-4905 Permit No. G-4624  
IN NAME OF

MELVIN E. KING

Surveyed April 20 1972, by D. Norby