


T.7 S. R.2W. W.M.

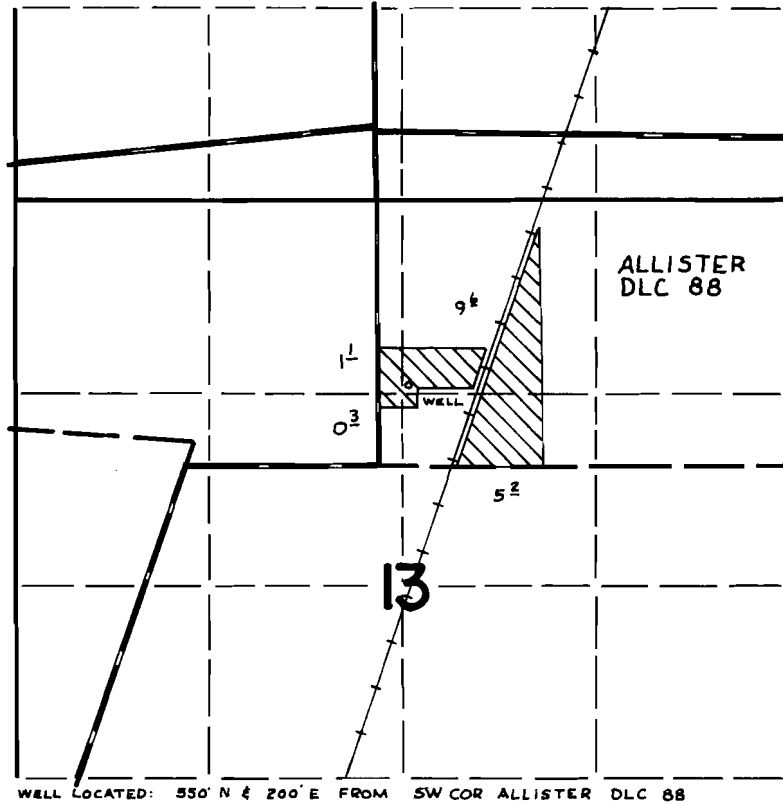

FINAL PROOF SURVEY UNDER

Application No. G-5282 Permit No. G-4840
IN NAME OF

SHERMAN R. HOFSTETTER

Surveyed April 27 19 72, by D. Norby