


T. 6 S. R. 3 W. W. M.

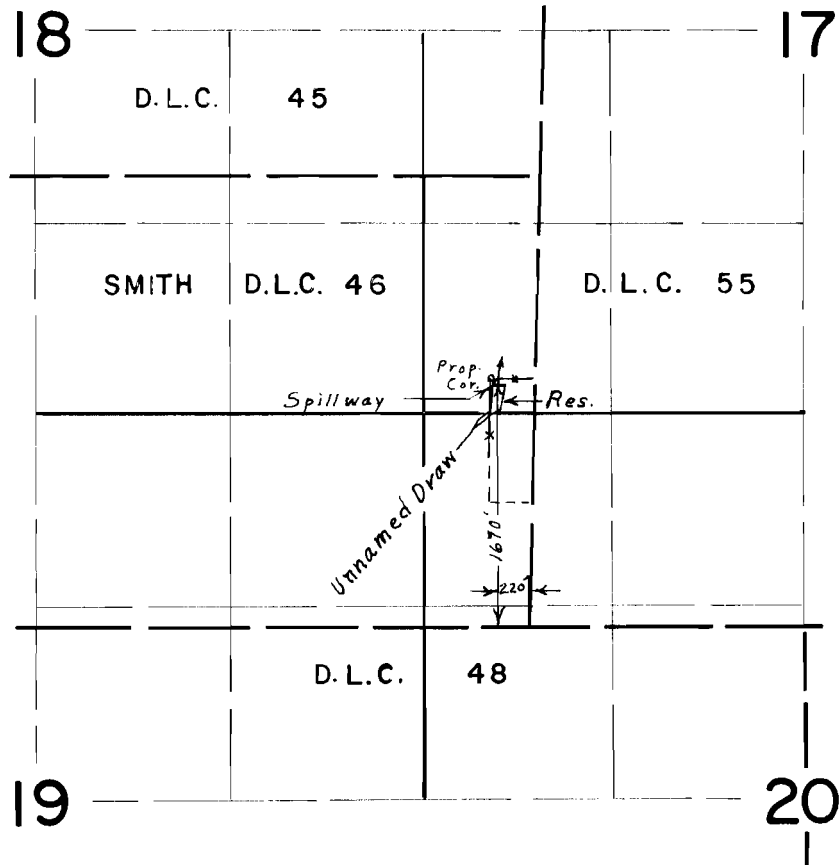

FINAL PROOF SURVEY
UNDER

Application No. R-46753 Permit No. R-5589
IN NAME OF

JAMES H. JOHNSON, JR.

Surveyed April 25, 1972, by L. E. Gould