


T. 3N.R.3W.W.M.

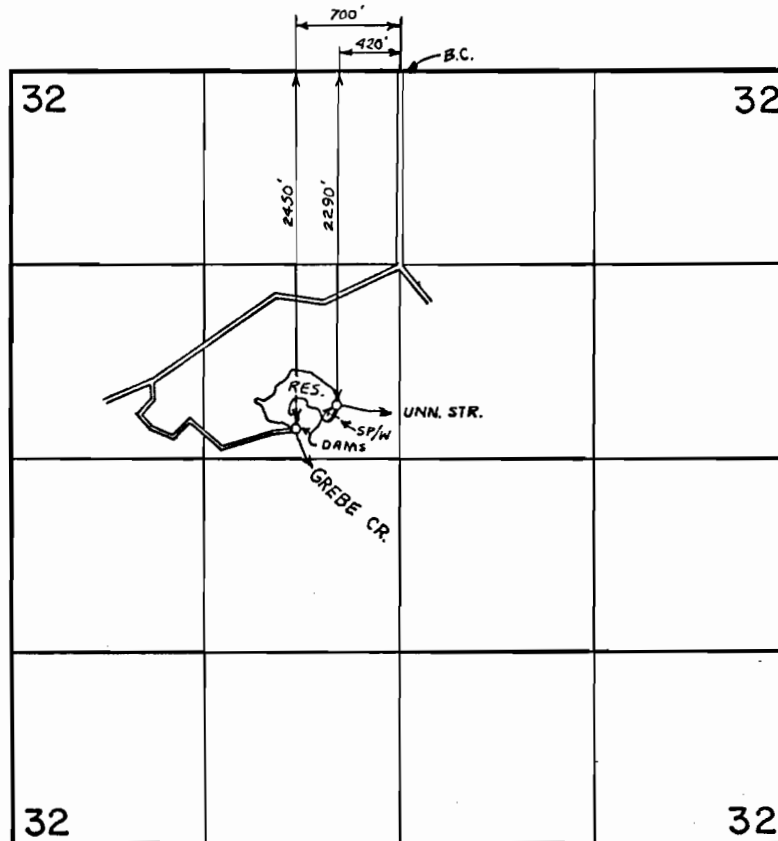

FINAL PROOF SURVEY
UNDER

46022 34007
Application No. R-46021 Permit No. R-5386
IN NAME OF

EUGENE SPANIOL

Surveyed JUN 29 1973, by R.G. MUCKEN