


T. 30S. R. 4W. W.M.

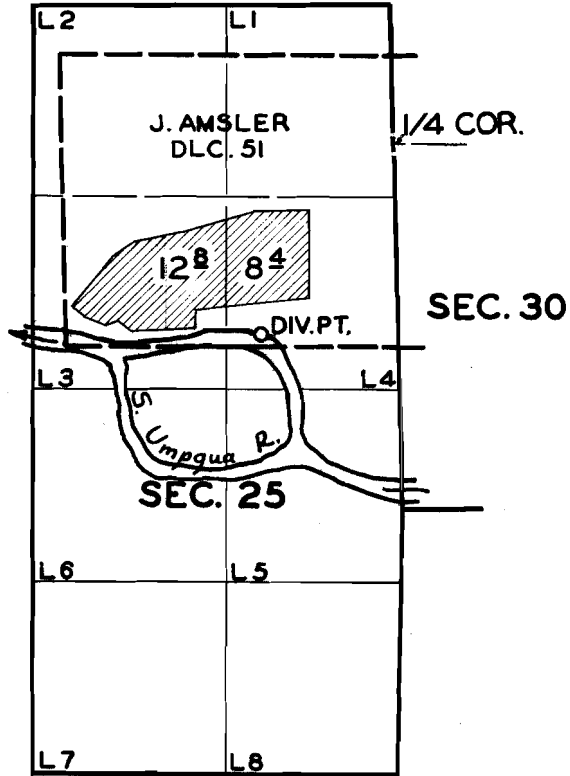

FINAL PROOF SURVEY  
UNDER

Application No. 27756. Permit No. 2185.4  
IN NAME OF

A. C. LAUBACK

Surveyed APR. 18. 1957. by C. O. BARTELS