
T.38S.,R.3W.,W.M.

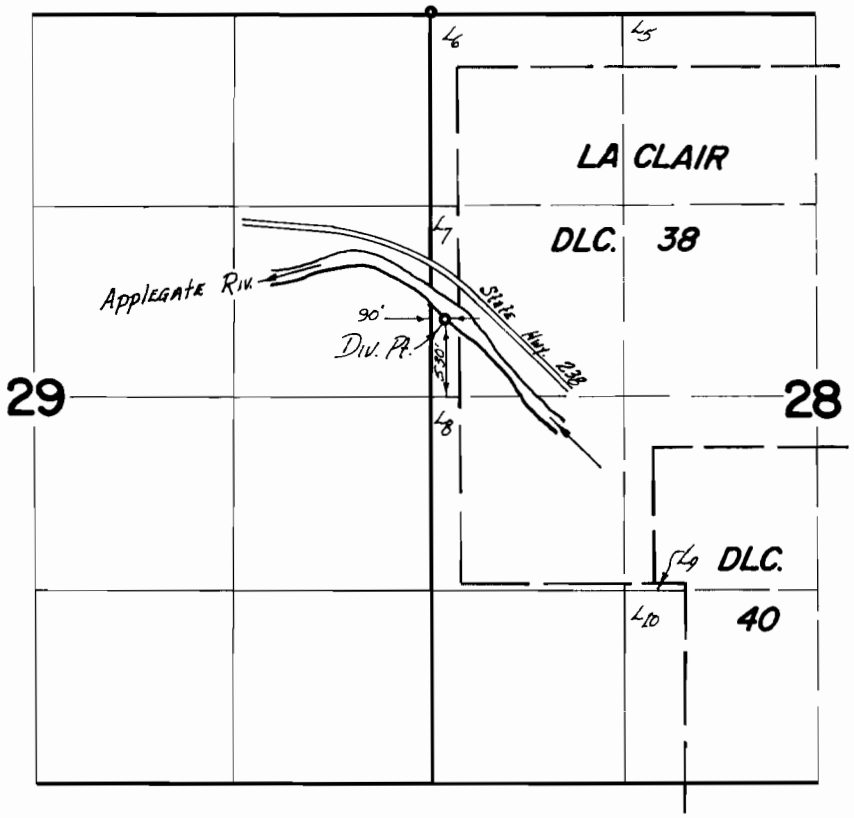

FINAL PROOF SURVEY
UNDER

Transfer No. 2536
Application No. ..... Permit No. .....
IN NAME OF

JOY C. NEWMAN

Surveyed Oct. 18 19 73, by D. NORBY

BAX-4AA-83