


# T. 40 S. R. 3 W. W. M.

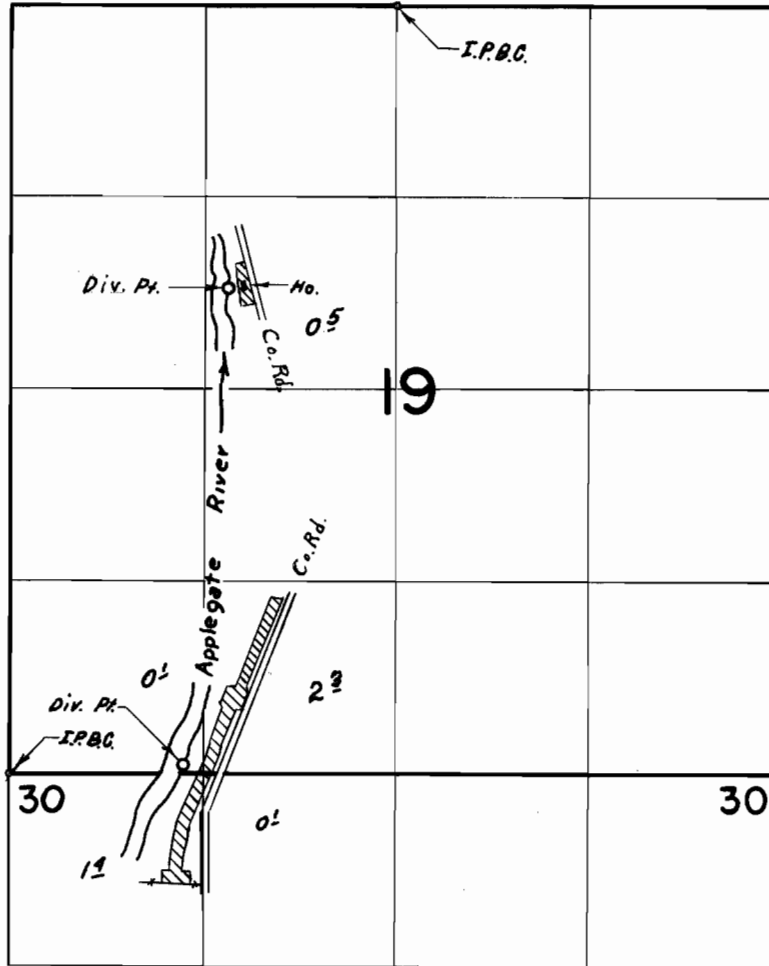

DIV. PTS. LOC.: DIV. NO. 1 - 50' N & 1190' E FROM SW COR. SEC. 19  
 DIV. NO. 2 - 1940' S & 1160' W FROM N 1/4 COR. SEC. 19

## FINAL PROOF SURVEY UNDER

Application No. 37843... Permit No. 28212...  
 IN NAME OF

.....MRS. GERTRUDE HEITKAMP.....

Surveyed SEP. 17, 1971, by L. E. Gould.....