


T. 12S. R. 1W. W.M.

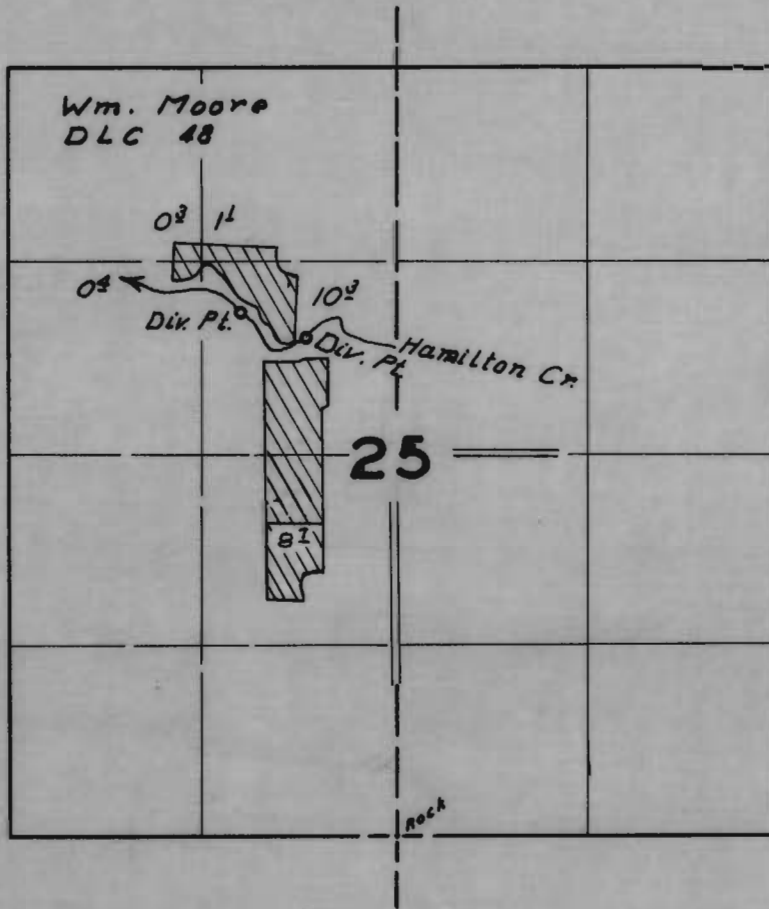

FINAL PROOF SURVEY

UNDER

Application No. 26449 Permit No. 20738

IN NAME OF

*F. R. & Zelphia Burian*

Surveyed Aug. 31. 19 59, by *R. H. Jackson*