


T.4S. R.1W.W.M.

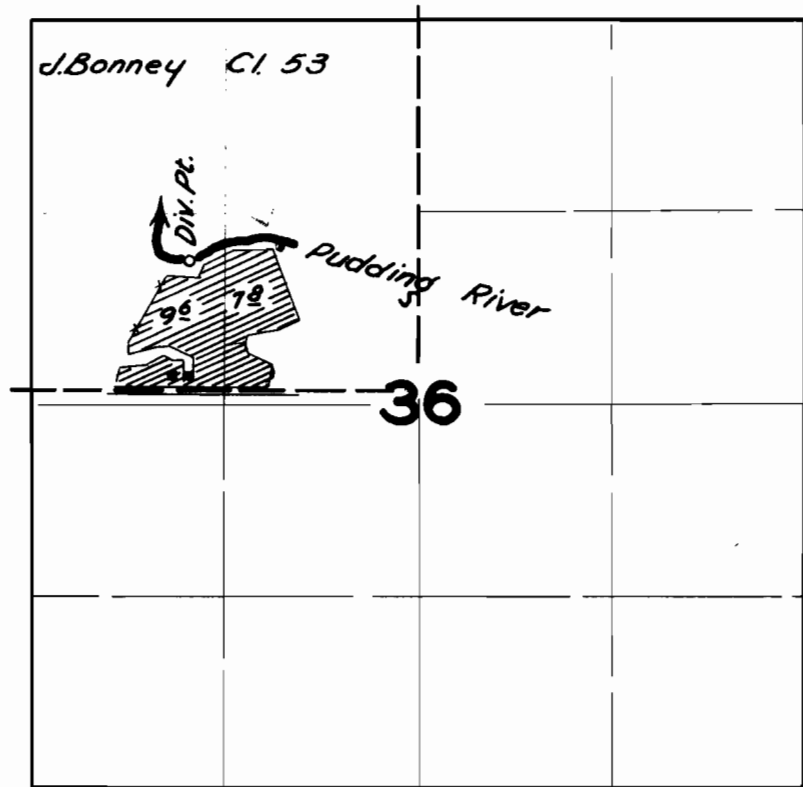

FINAL PROOF SURVEY UNDER

Application No. 24039 Permit No. 19193

IN NAME OF

CLIFFORD R. HYLAKKE

Surveyed Aug. 28 1952, by H. L. COFFMAN