


# T. 4 S. R. 2 W. W. M.

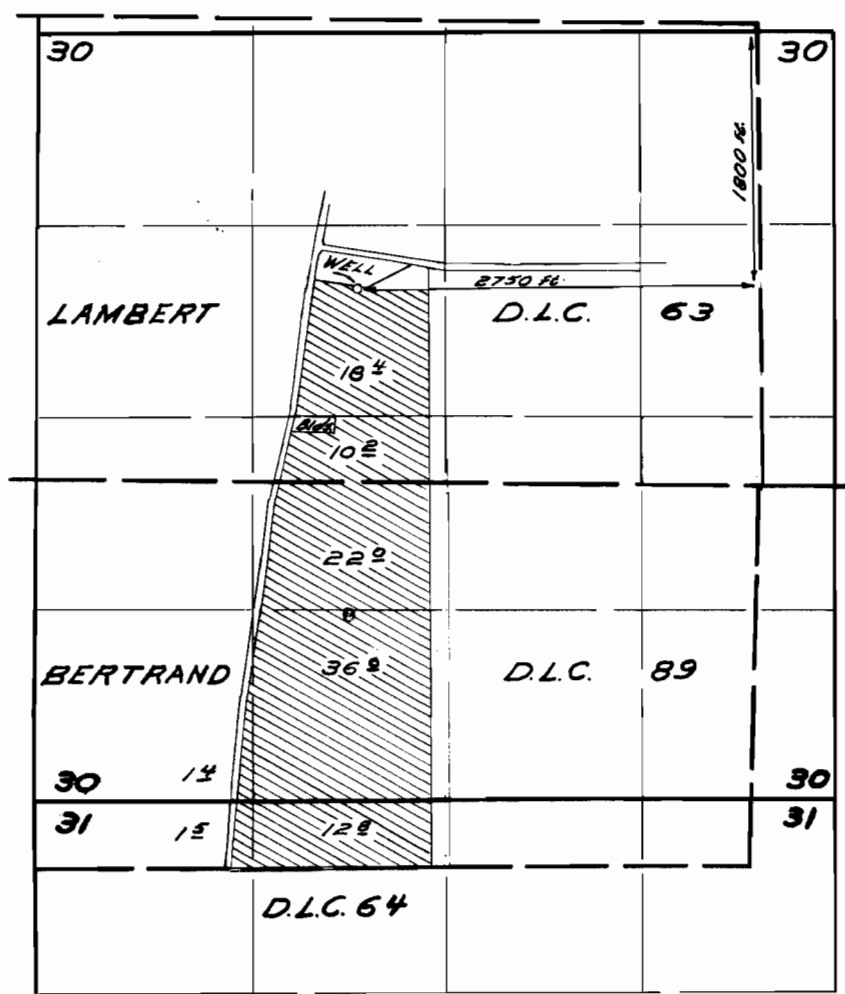

## FINAL PROOF SURVEY UNDER

Application No. G-2505 Permit No. G-2359  
IN NAME OF

CLAUDIO BUSTAMANTE

Surveyed April 6, 1967, by N.J. Ruppert