


T.5S. R.1W.W.M.

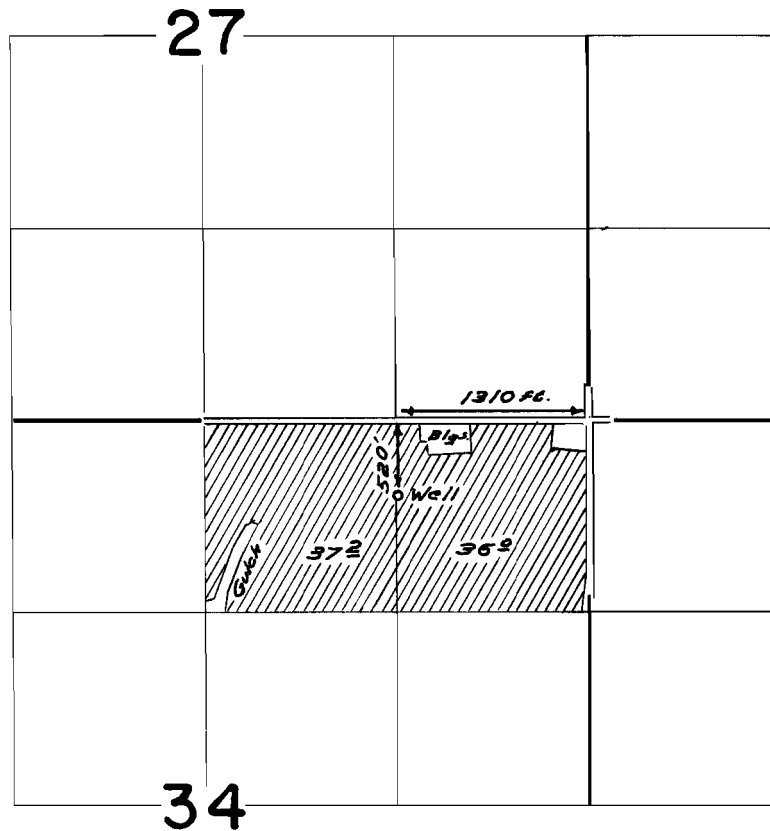

FINAL PROOF SURVEY
UNDER

Application No. G-2675 Permit No. G-2479
IN NAME OF

Carl Ertelt

Surveyed Sept 2 1966, by W. J. Ruppert