


T. 6 S. R. 1 W. W. M.

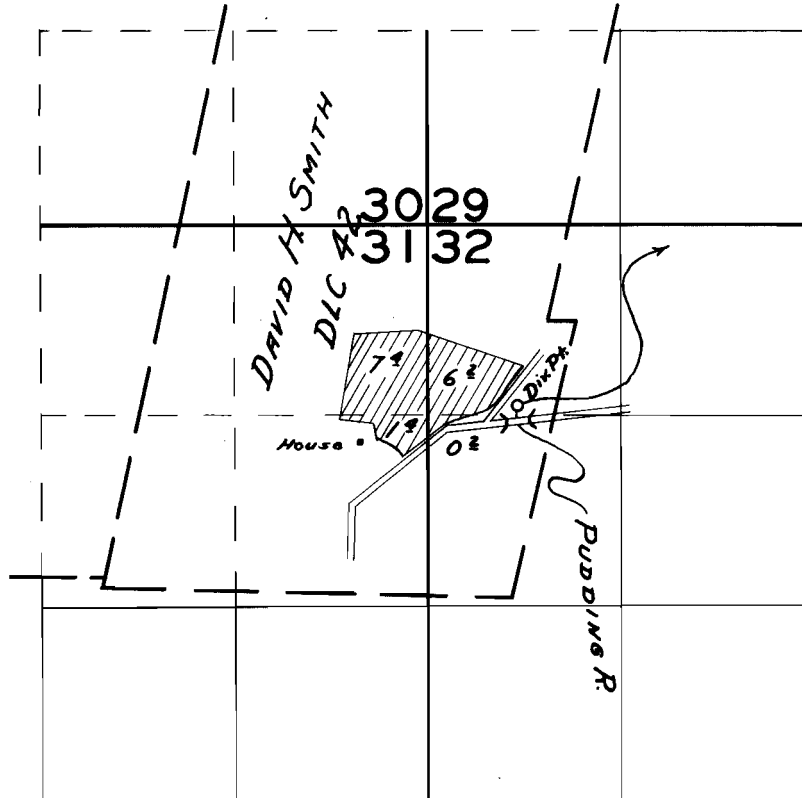

**FINAL PROOF SURVEY**

UNDER

Application No. 21134 Permit No. 16563

IN NAME OF

ESTATE OF ANTON A. PEEFER

Surveyed MAY 24 1956, by G.O. BARTELS

DFN-2D-201