


T.6S.R.1W.W.M.

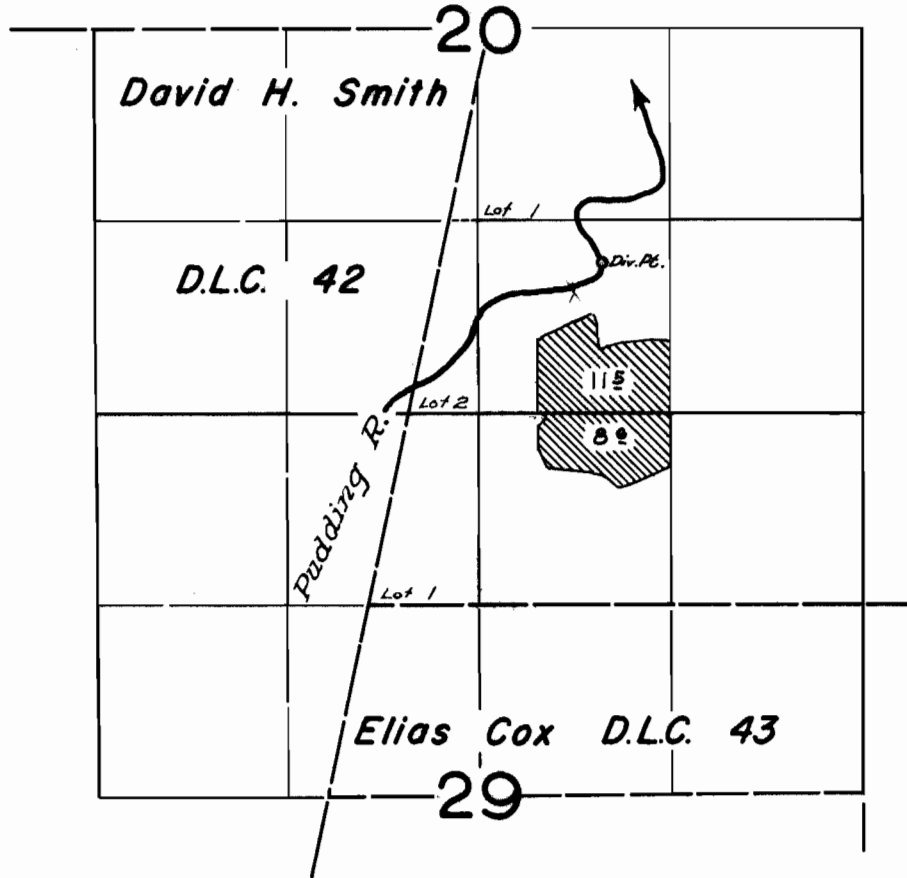

FINAL PROOF SURVEY
UNDER

Application No. 33161..... Permit No. 26214.....
IN NAME OF

L. & VERNIECE MEISENHEIMER

Surveyed June 1, 1962, by *A. H. Nelson*