


T.9S. R.2E.W.M.

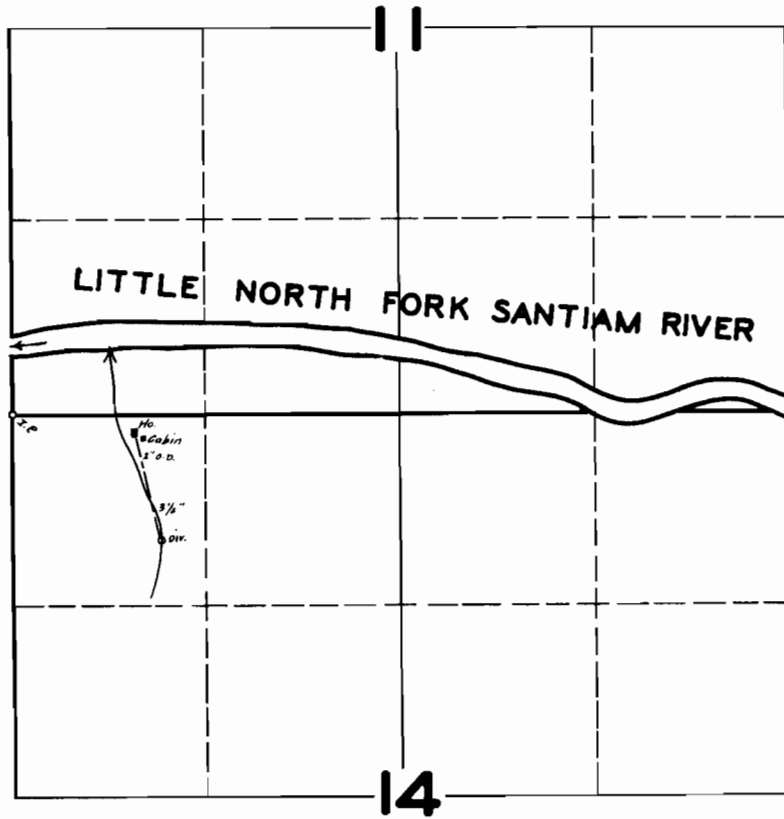

**FINAL PROOF SURVEY
UNDER**

Application No. 17393 Permit No. 13093

IN NAME OF

CLIVE L. MITCHELL & REBA F. MITCHELL

Surveyed MAR. 26 1946 by [Signature]