


T.8S. R.6W. W.M.

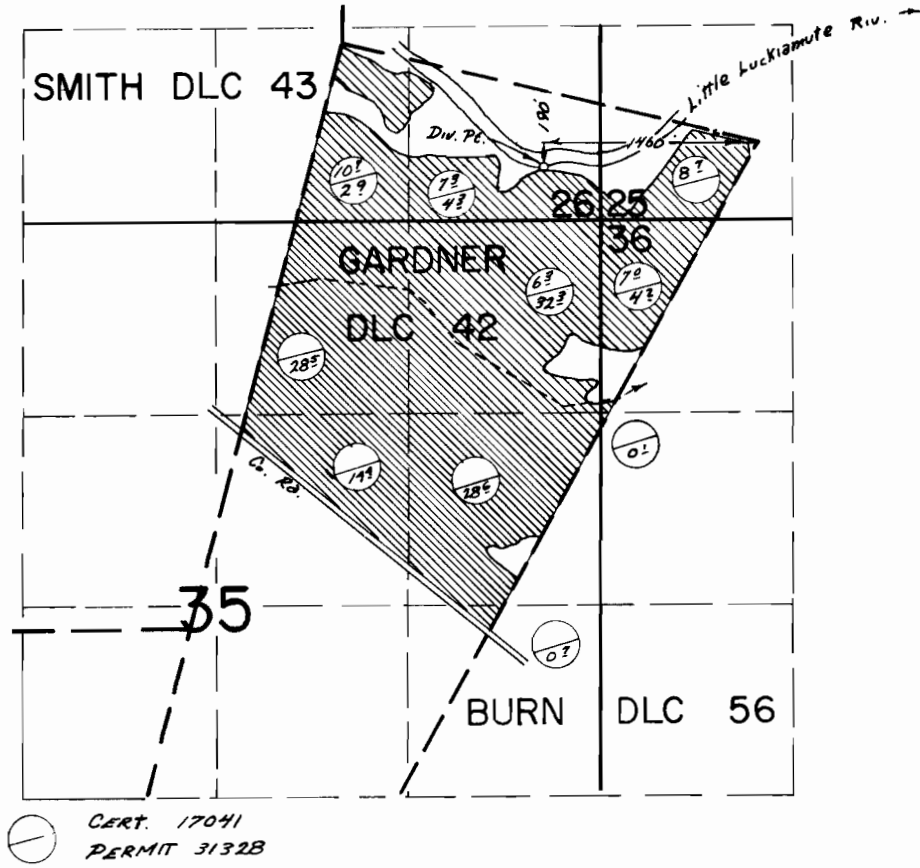


FINAL PROOF SURVEY
UNDER

Application No. 41874 Permit No. 3132B
IN NAME OF

KENNETH GARDNER

Surveyed Nov. 21 1972, by L. E. Gould

T.8S.R.6W.W.M.

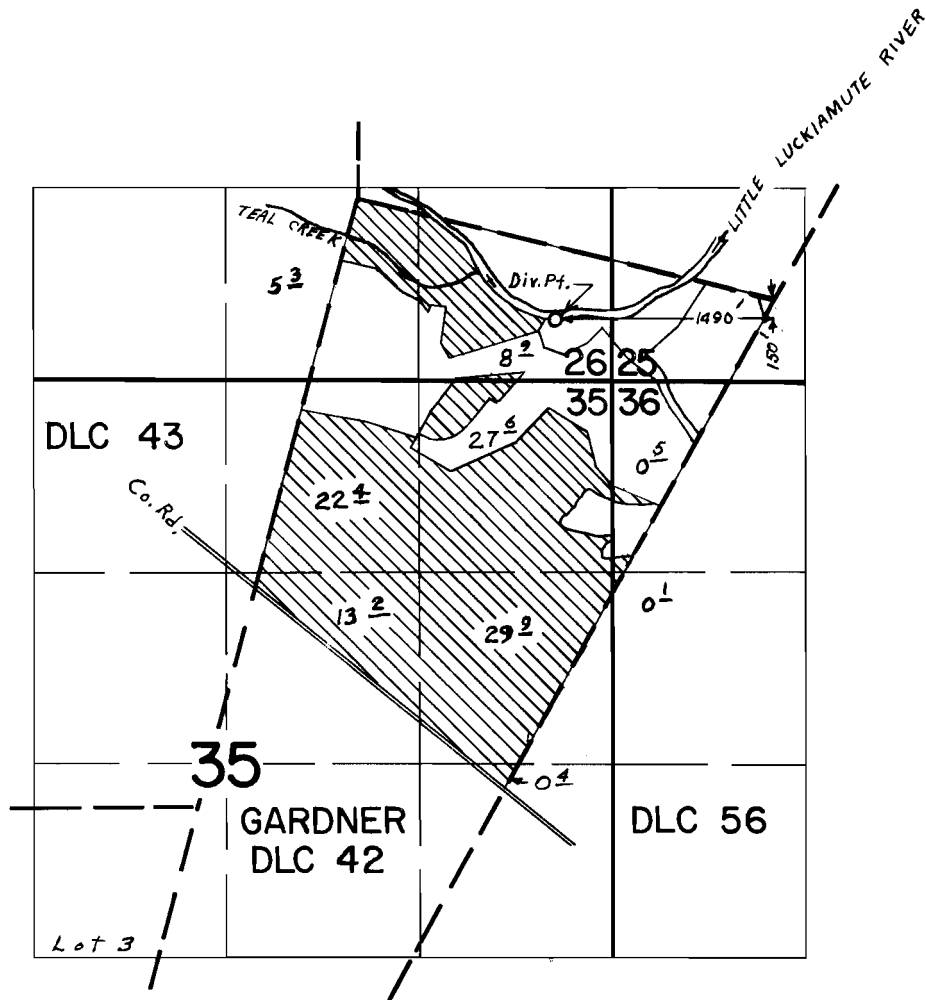

FINAL PROOF SURVEY
UNDER

Application No. 41874 Permit No. 31328
IN NAME OF

KENNETH GARDNER

Surveyed NOV 21 1972, by L. GOULD