


# T.6N.,R.33 & 34E.,W.M.

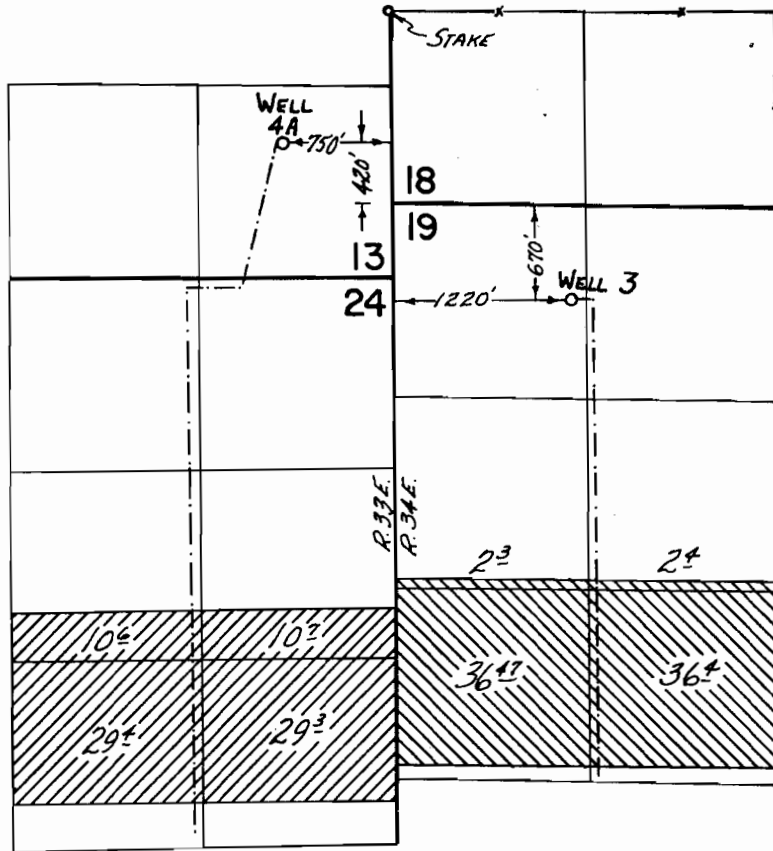

## FINAL PROOF SURVEY UNDER

Transfer No. G-63  
 Application No. G-523 Permit No. G-406  
 IN NAME OF

JOHN L. GEYER

Surveyed MAY 4-7 1971, by G. BACA