


T.6N.,R.33 & 34E.,W.M.

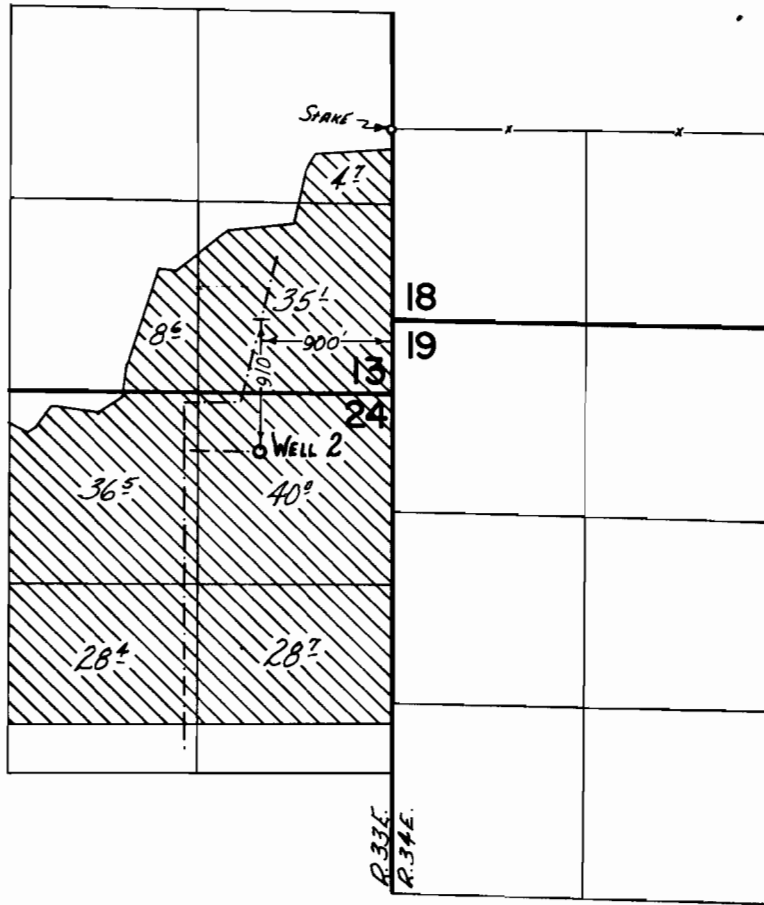

FINAL PROOF SURVEY
UNDER

Application No. G-180 Permit No. G-120
IN NAME OF

JOHN L. GEYER

Surveyed MAY 4-7 19 71, by G. BACA