


T.6N.,R.33 & 34E.,W.M.

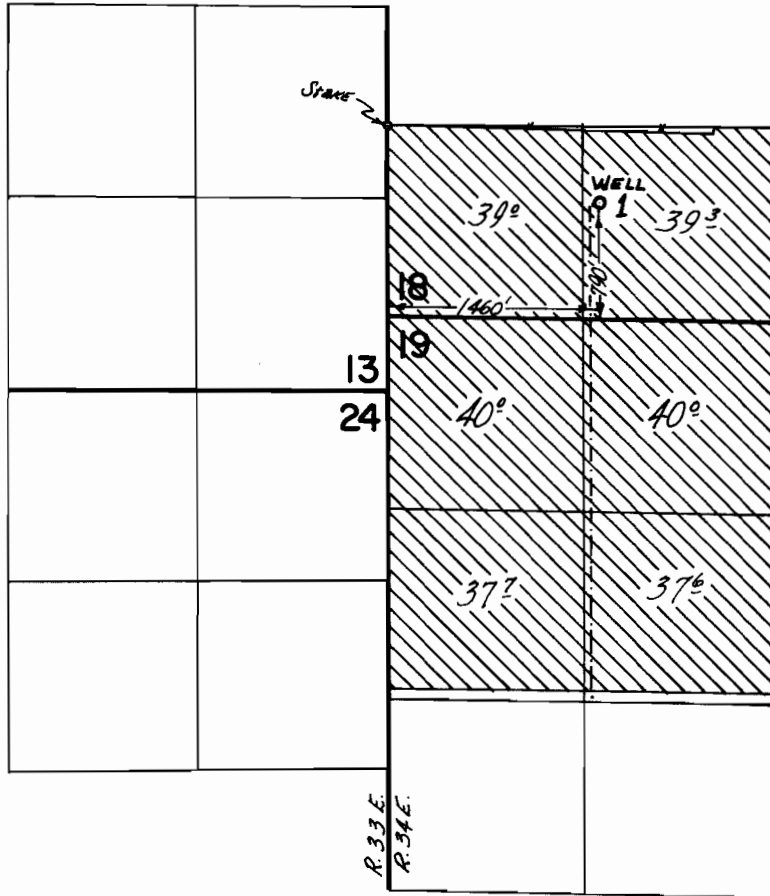

**FINAL PROOF SURVEY**  
UNDER

Application No. U-579 Permit No. U-568  
IN NAME OF

JOHN L. GEYER

Surveyed MAY 4-7, 1971, by G. BACA