


T.2S.R.44 E.W.M.

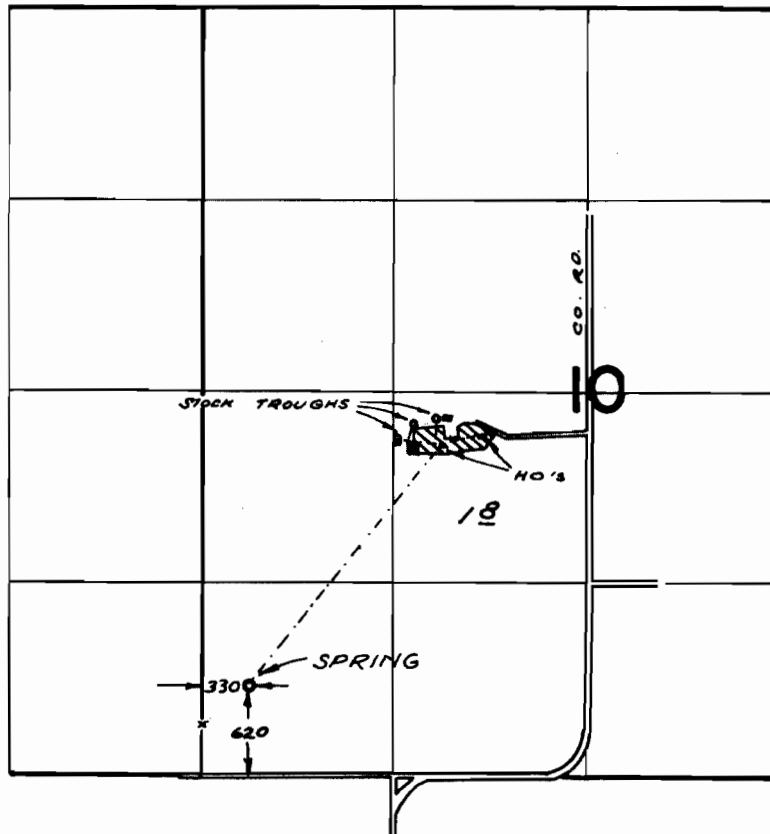

FINAL PROOF SURVEY UNDER

Application No. 46706 Permit No. 35129
IN NAME OF

H. A. SLINKER

Surveyed JUNE 29, 1972, by R. MUCKEN