


T. 5 S. R. 5 & 6 W. W. M.

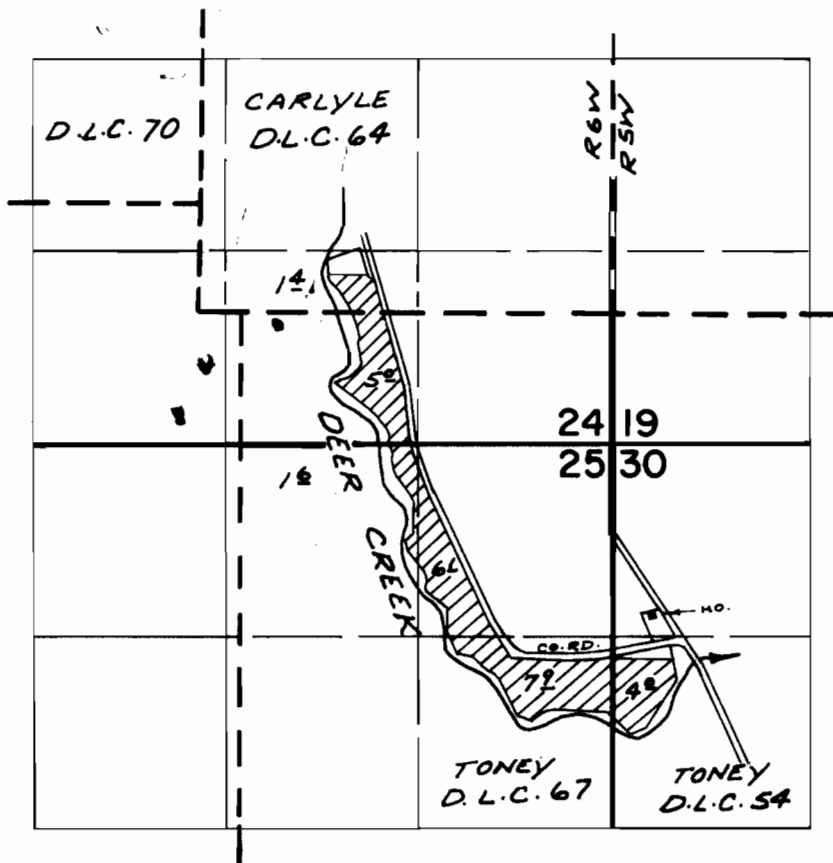

FINAL PROOF SURVEY UNDER

Application No. 18092 Permit No. 73752
IN NAME OF

EUGENE MCKINLEY

Surveyed SEPT. 21, 1951, by H. L. COFFMAN
FEB 13, 1973 R. MUCKEN