


T. 23 S. R. 33 & 34 E. W. M.

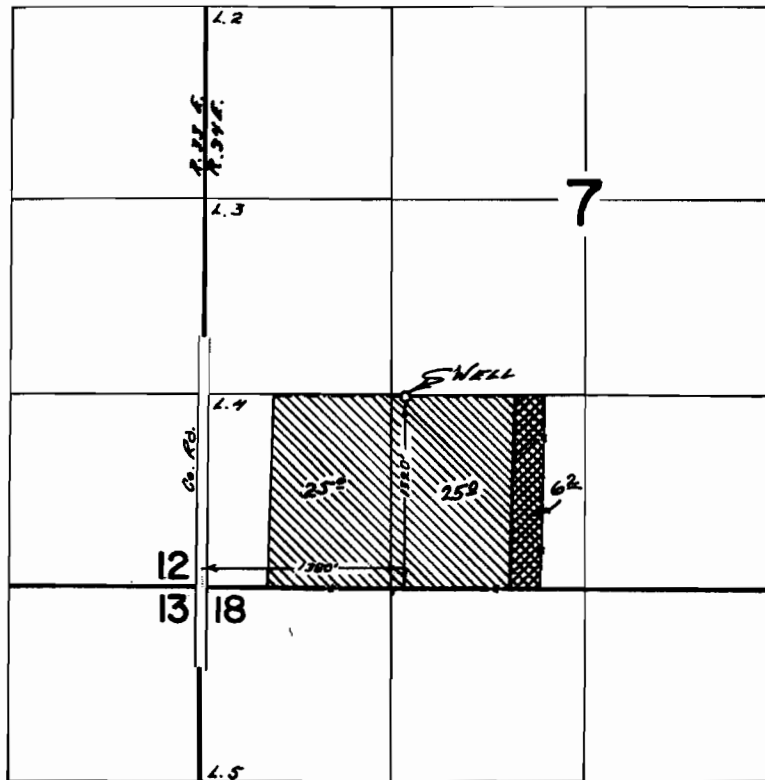

FINAL PROOF SURVEY
UNDER

Application No. G-6462 Permit No. G-5227
G-4972 G-4689
IN NAME OF

LYLE E & HELEN VICKERS

Surveyed Aug. 24 1972, by R. G. MUCKEN
JUNE 18, 1975 L. M. TOLL