


T.36S.R.3W.W.M.

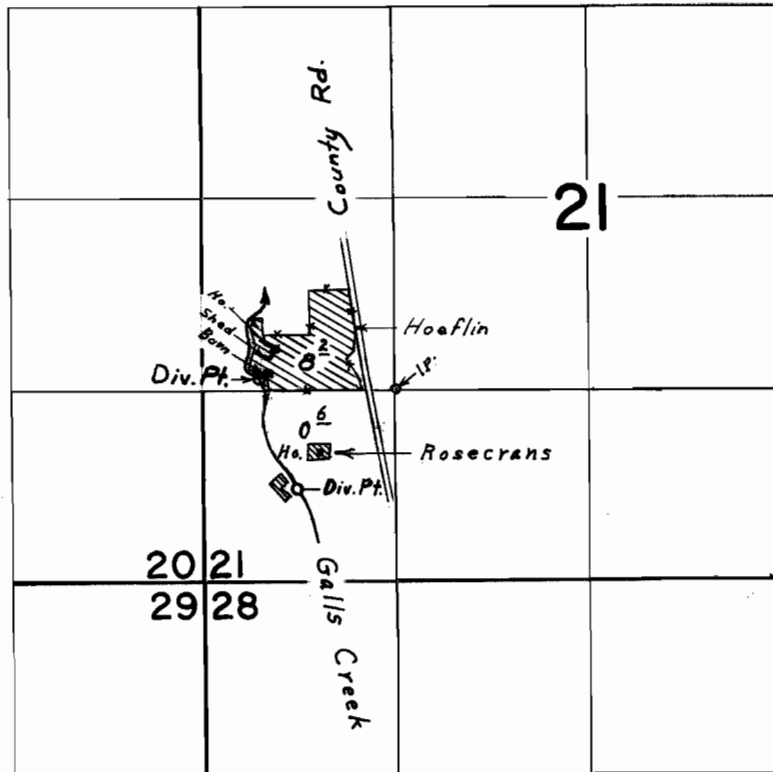

Div. Pts. located: Hoeflin, 80' N. & 930' W.; Rosecrans, 670' S. & 670' W., both from N. E. Cor. S. W. ¼ S. W. ¼ Sec. 21

FINAL PROOF SURVEY
UNDER

Application No. 41147..... Permit No. 30674.....
IN NAME OF

WALTER & LUCILLE HOEFLIN & GERTRUDE ROSECRANS

Surveyed Jun. 5, 1969, by L. E. Gould.....