


P. 26611
39869

T.9 S.R.18 & 19 E.W.M.

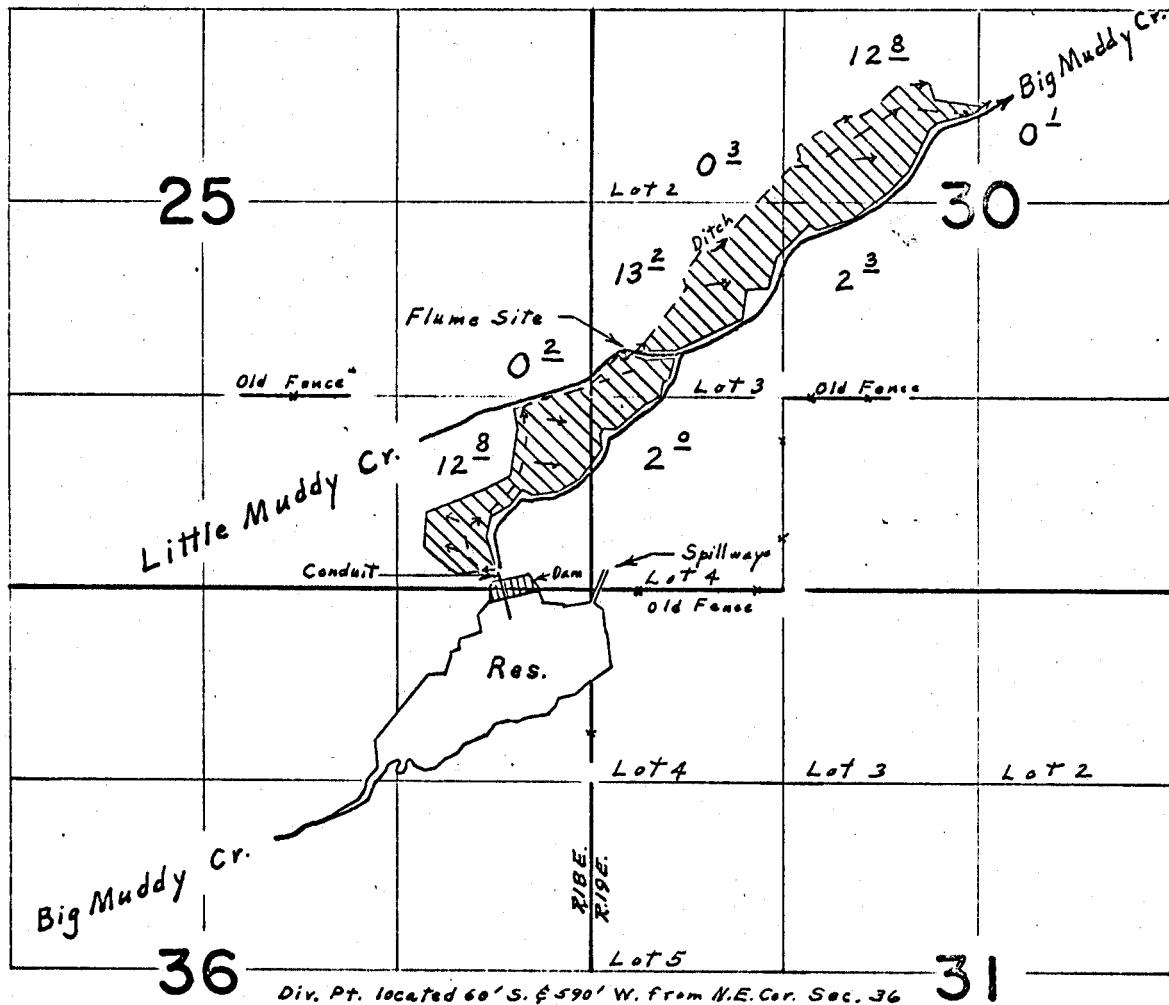

FINAL PROOF SURVEY
UNDER

R-33562 R-2331
Application No. 33563 Permit No. 26611
IN NAME OF

BIG MUDDY RANCH CO.

Surveyed June 16 1971, by L. E. Gould