


# T. 36S.R. 6W.W.M.

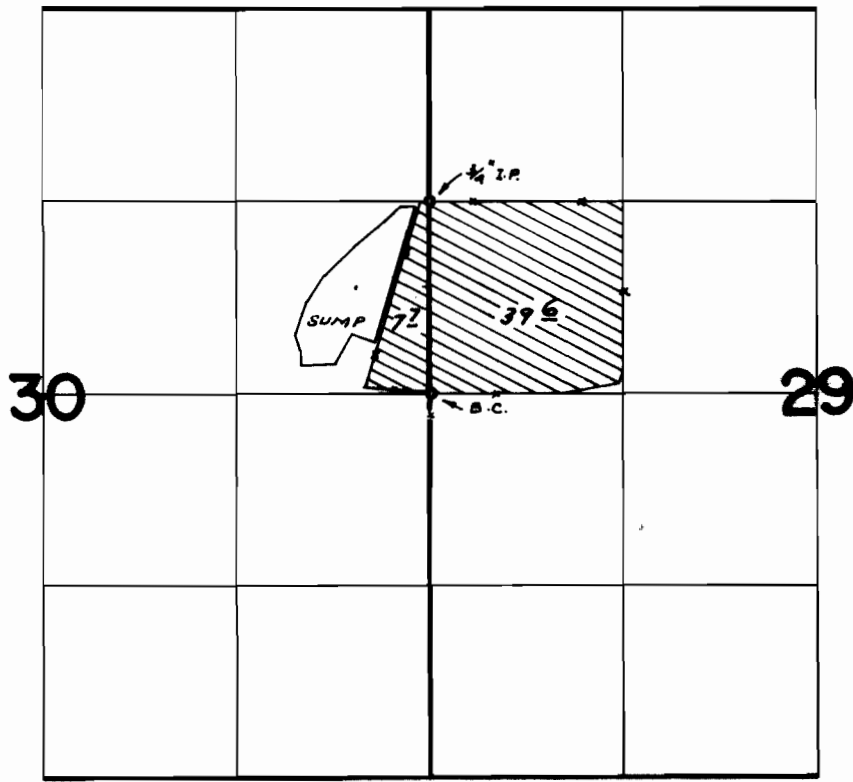

SUMP LOC: 700' N. & 500' W. FROM E 1/4 COR. SEC. 30

## FINAL PROOF SURVEY UNDER

Application No. G-4359 Permit No. G-4113  
IN NAME OF

THOMAS R. HART

Surveyed APR. 20 1972, by R. MUCKEN